


2032 200 Q-96-B

Plat Showing  
Blocks 124-128-129-130-132-133-137  
of Reservation Addition  
City of Pendleton-Ore.  
And  
Location of Pendleton Woolen Mills Property  
Scale 1"=100'  
Surveyed & Platted  
By W. E. O. Criger  
Date. Sept. 17-18-1947

SW 1/4 SE 1/4

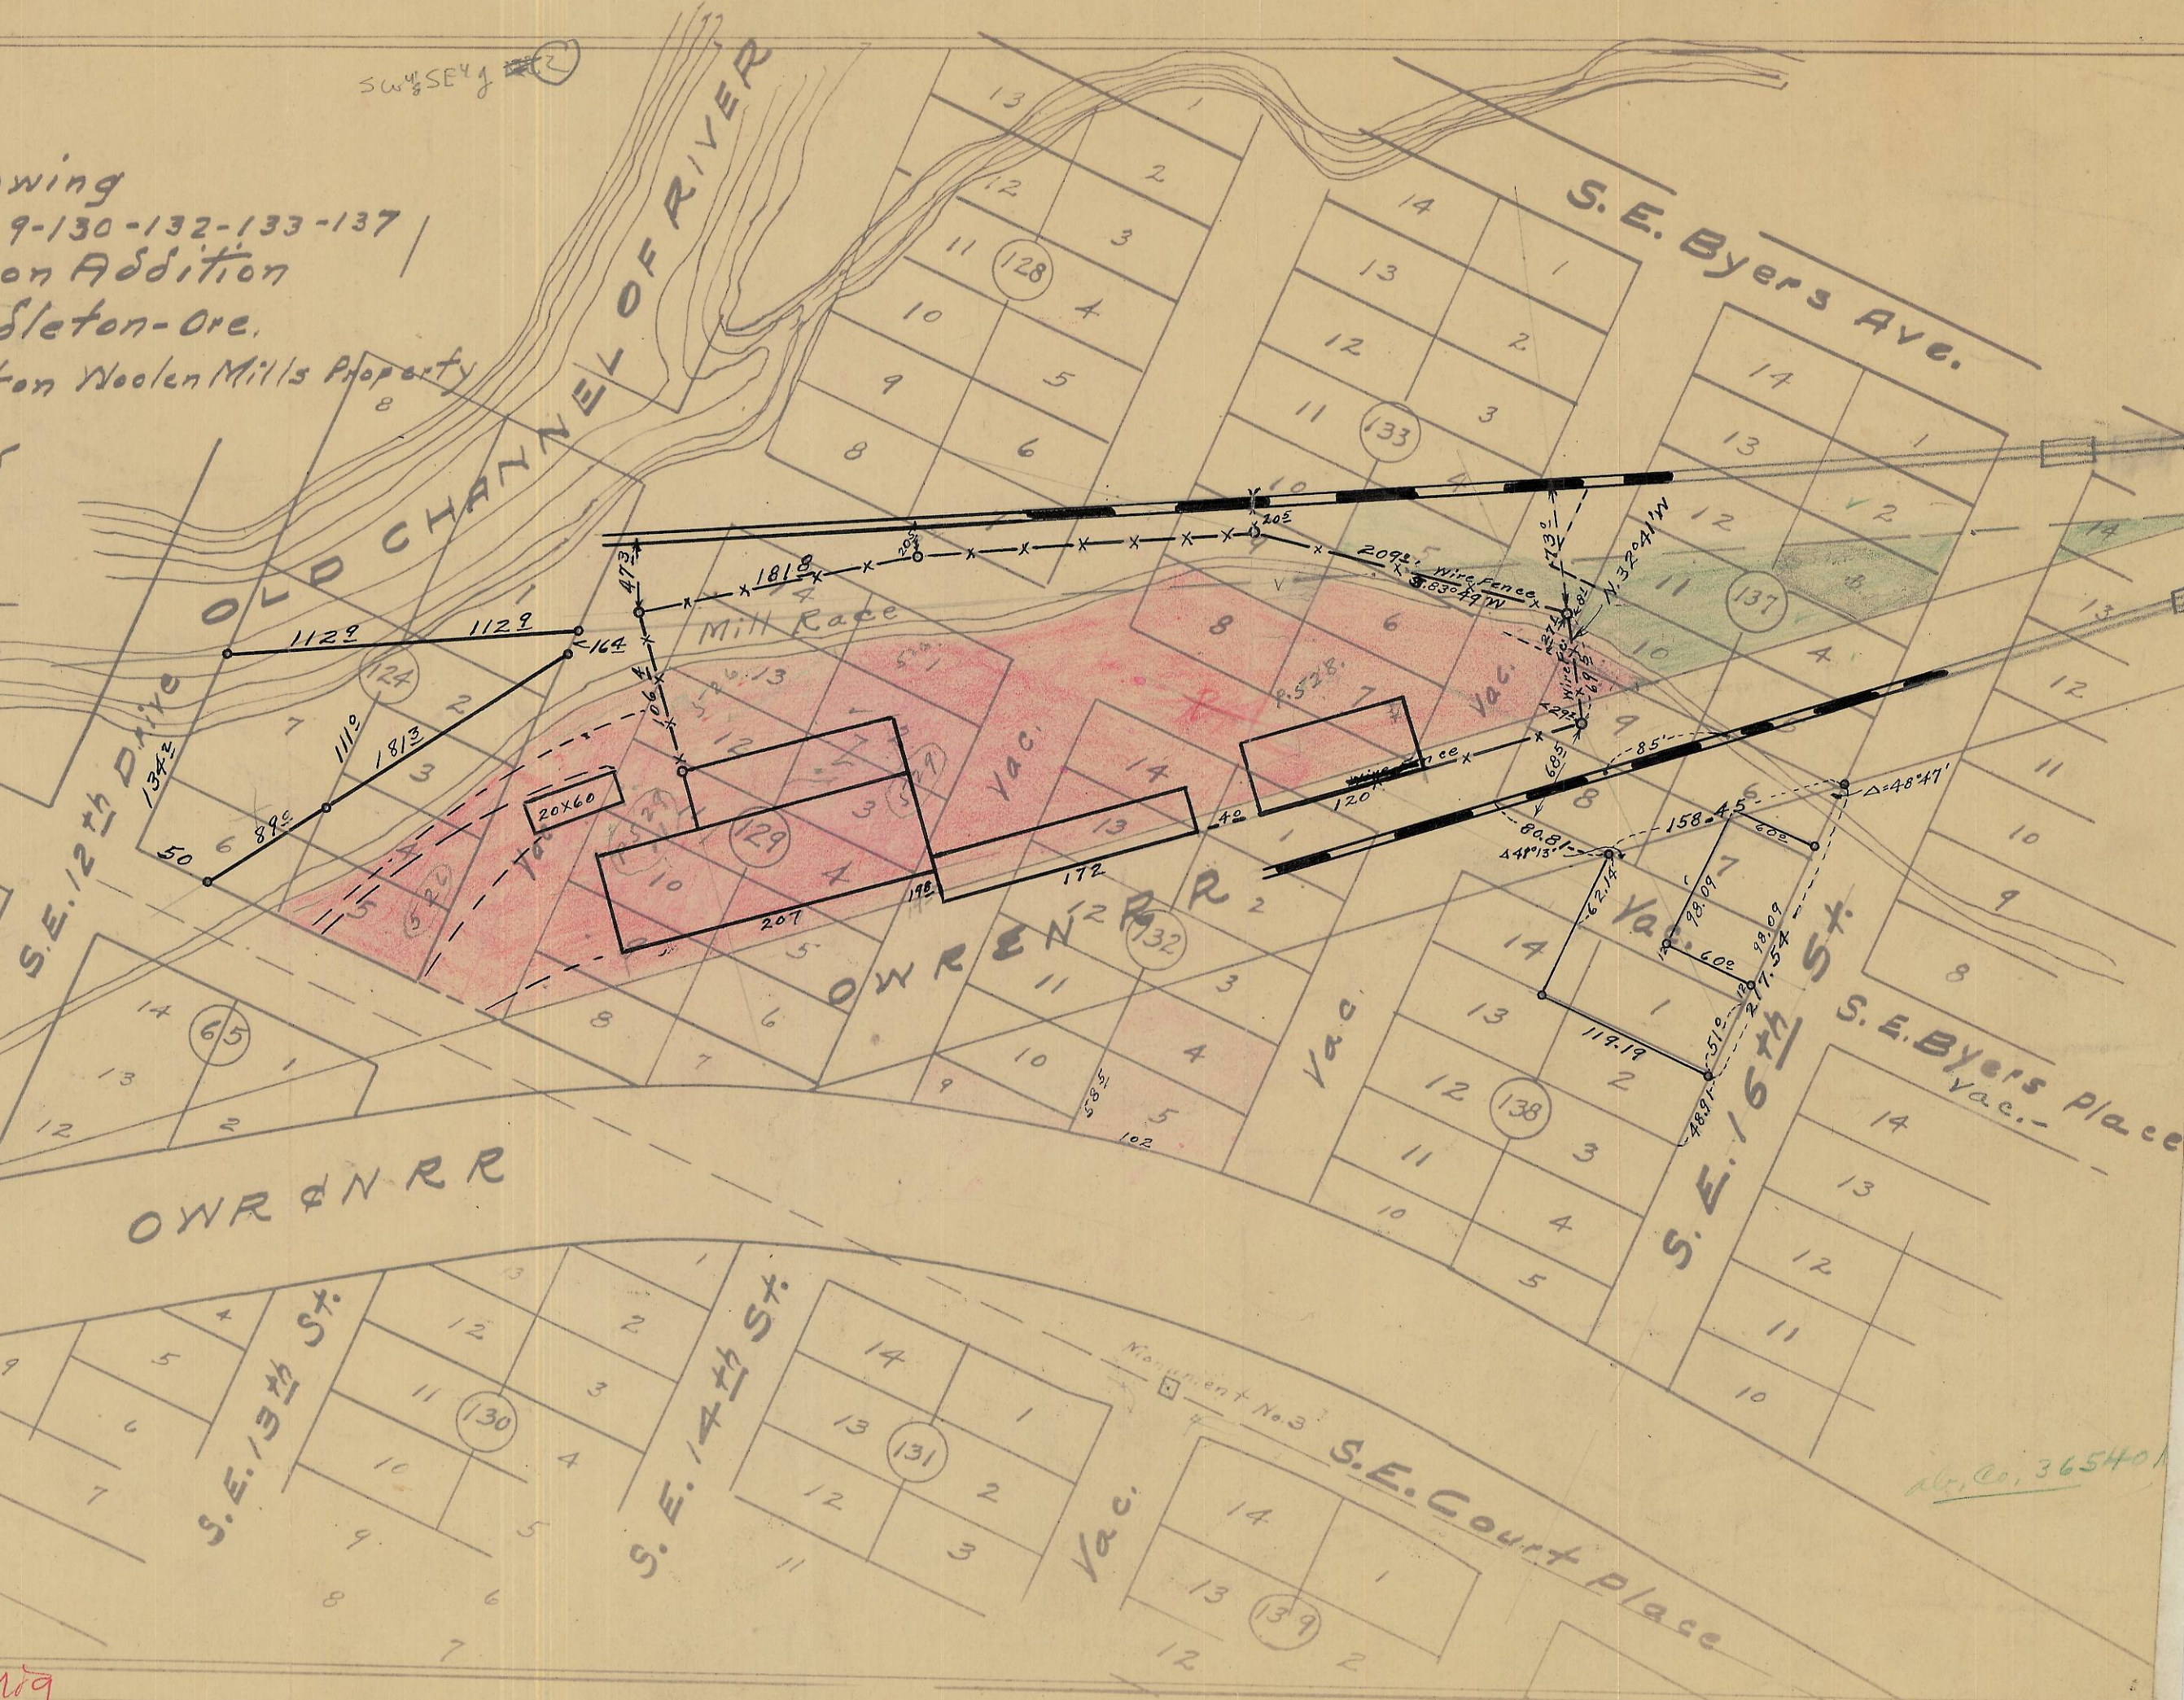

181 Q-96-B

orig

No. Co. 365401