RECORD SURVEY

E. A. WHITE

LOTS 1, 2, 3, BLOCK 6, BROWNELL'S ADDITION
CITY OF UMATILLA

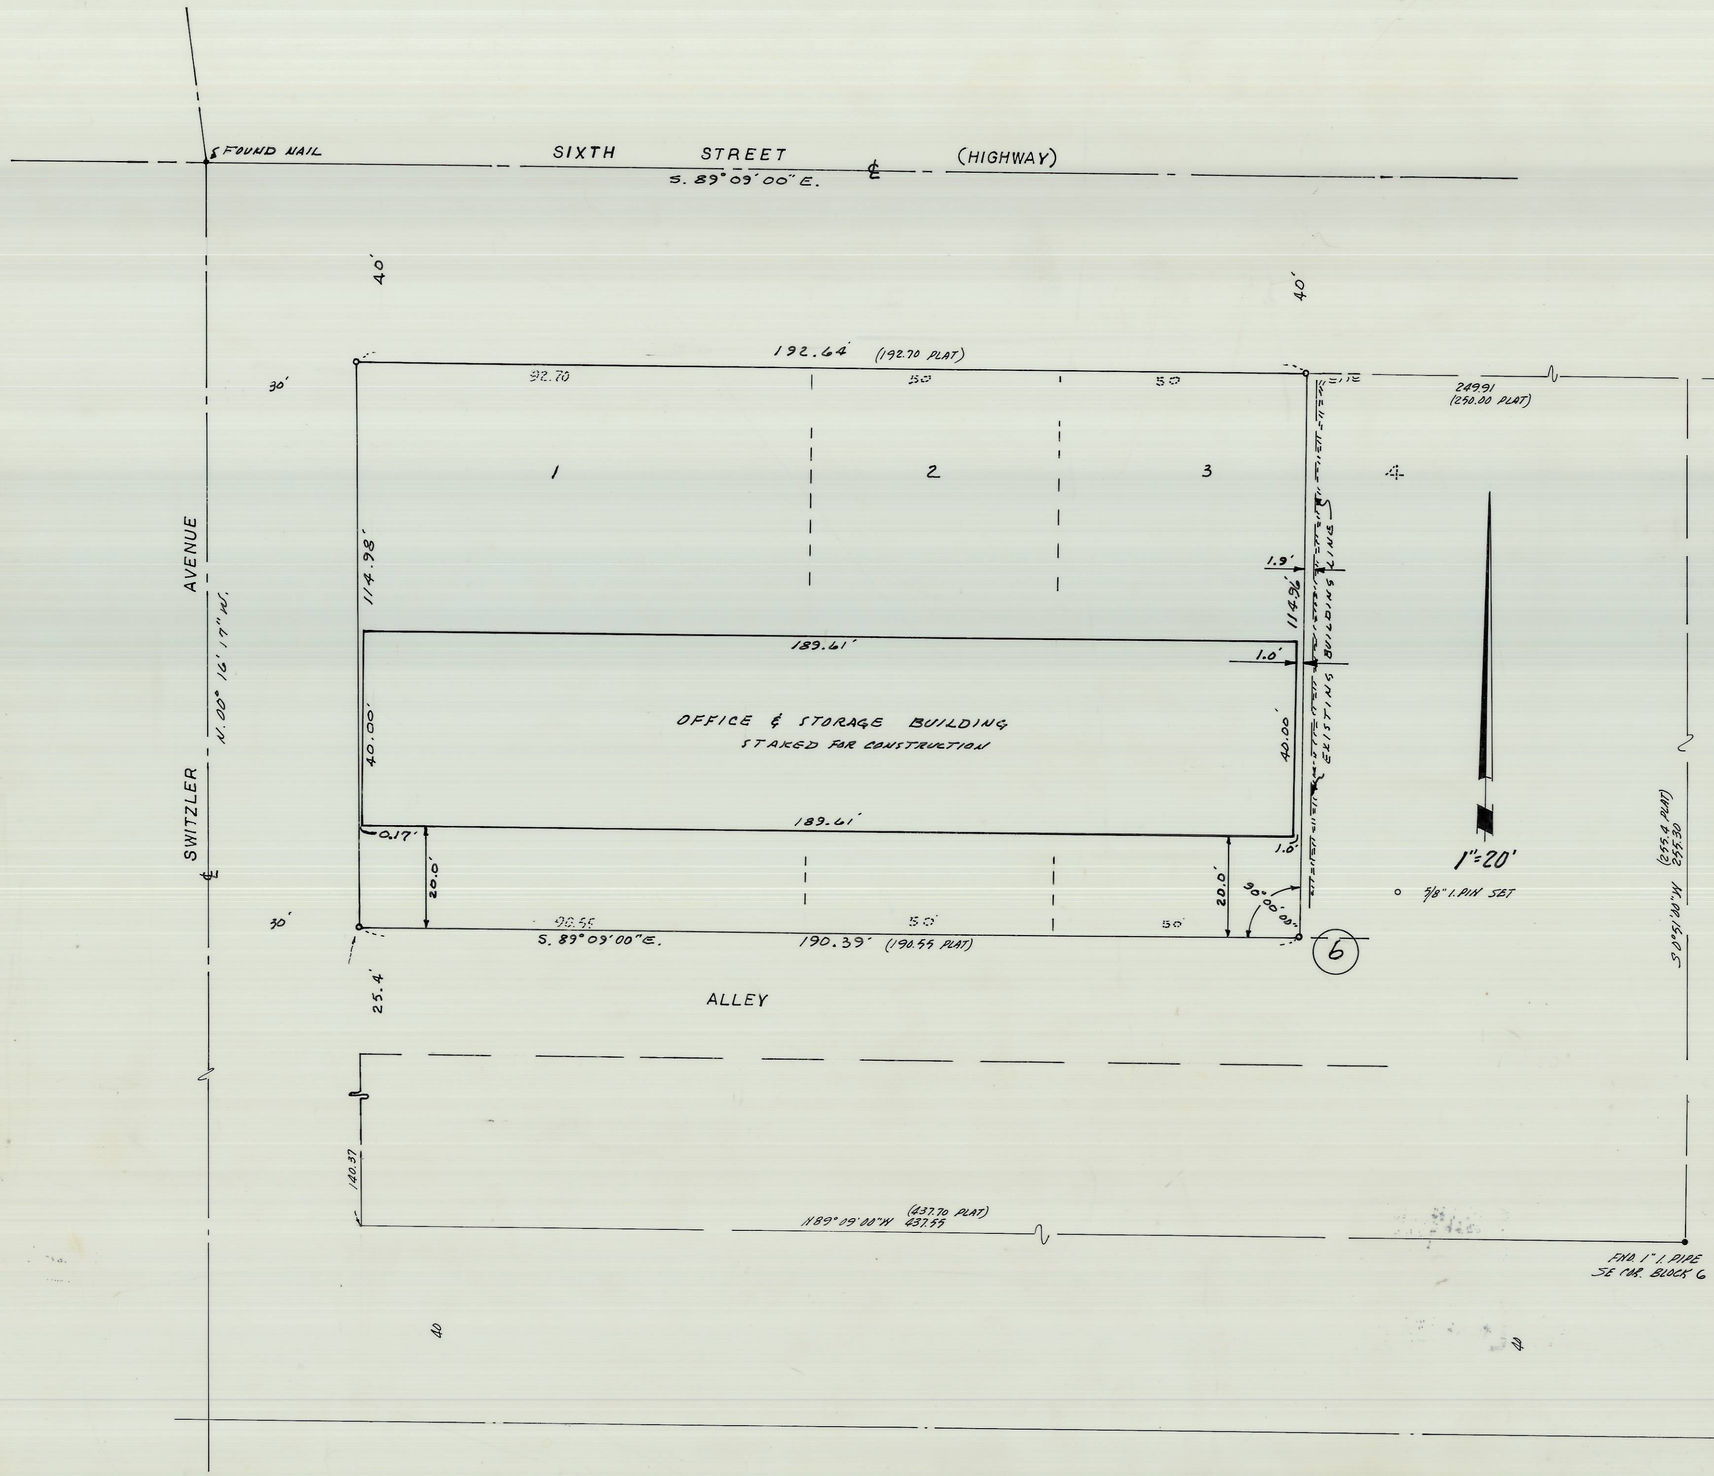

DESCRIPTION

LOTS 1, 2 AND 3, BLOCK 6, BROWNELLS ADDITION TO CITY OF UMATILLA, OREGON, ACCORDING TO PLAT THEREOF RECORDED IN VOLUME 5 OF TOWN PLATS, PAGE 31, RECORDS OF UMATILLA COUNTY, OREGON.

BASIS OF BEARING

CENTERLINE OF SIXTH STREET BEING SOUTH 89°09'00" EAST AS SHOWN ON PLAT OF BROWNELLS ADDITION TO CITY OF UMATILLA.

SURVEYOR'S CERTIFICATE

I, DAVID G. CHRISTENSON, A PROFESSIONAL LAND SURVEYOR IN THE STATE OF OREGON, HEREBY CERTIFY THAT THE SURVEY AS SHOWN HEREON IS BASED ON AN ACTUAL FIELD SURVEY OF THE LAND DESCRIBED AND THAT ALL ANGLES, COURSES, AND DISTANCES ARE CORRECTLY SHOWN AND THAT THE SAID SURVEY IS STAKED ON THE GROUND AS INDICATED HEREON.

REGISTERED PROFESSIONAL LAND SURVEYOR
David G. Christenson 3/26/79
OREGON DECEMBER 17, 1976 DAVID G. CHRISTENSON 1094

RECEIVED BY
Umatilla County Surveyor
Date March 26, 1979
Rec'd By MH
No. Q-919-B

WORLEY SURVEYING SERVICE, INC. P.S.
124-A VISTA WAY
KENNEWICK, WASHINGTON 99336

Q-919-B 79-38