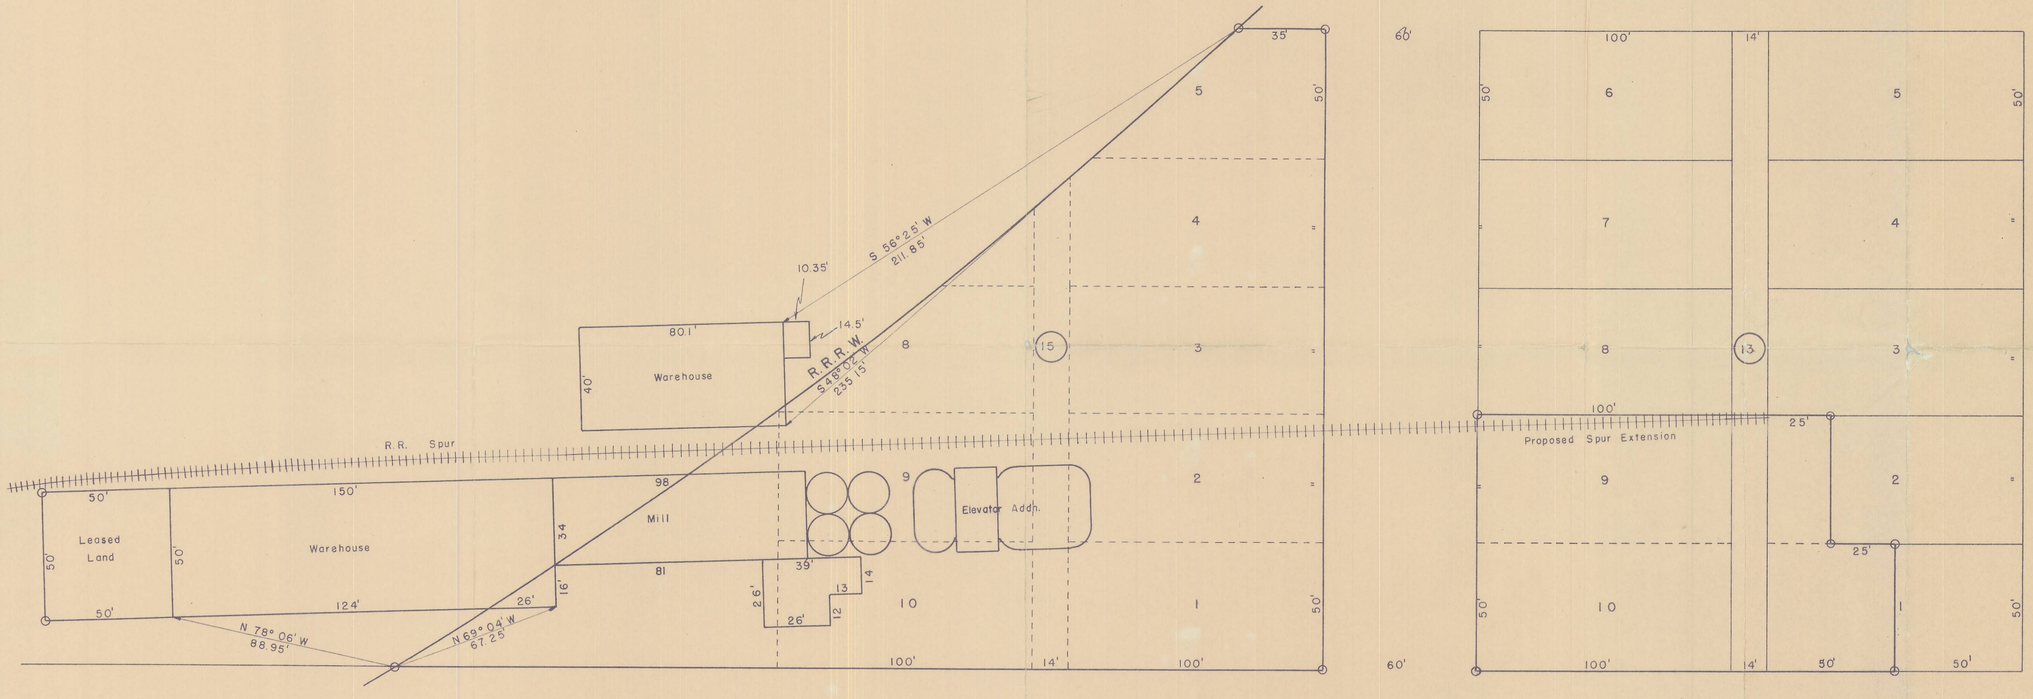

Numbers at ℄ Denote Distance From S. 1/4 Cor.
S. 2, T. 4 N., R. 33 E.W.M.

HAYES & HARRIS ENGINEERING

SURVEY

FOR

KERR GIFFORD & CO. INC.

OF

MILL & ELEVATOR SITE
HELIX, OREGON

Scale 1" = 30' July 29, 1954

REGISTERED PROFESSIONAL ENGINEER 197 OREGON JULY 8, 1919 F. B. HAYES

F. B. Hayes

Q-1132-B

963

Q-1132-B 4N 33