

35 36
2 1

36

36 31
1 6

NW 1/4 NW 1/4

NE 1/4 NW 1/4

NW 1/4 NE 1/4
40.11 AC.

NE 1/4 NE 1/4
16.42 AC.

.07 AC.

.81 AC.

SW 1/4 NW 1/4
10.00 AC.

SE 1/4 NW 1/4
39.82 AC.

SW 1/4 NE 1/4
36.91 AC.

SE 1/4 NE 1/4
1.29 AC.

2 1

Well

1 6

House
Yard

NW 1/4 SW 1/4
23.25 AC.

NE 1/4 SW 1/4
38.42 AC.

NW 1/4 SE 1/4
14.62 AC.

NE 1/4 SE 1/4

N. 47° 34' W
3942.2

SW 1/4 SW 1/4

SE 1/4 SW 1/4


SW 1/4 SE 1/4

SE 1/4 SE 1/4

2 1
11 12

1 12

1 6
12 7

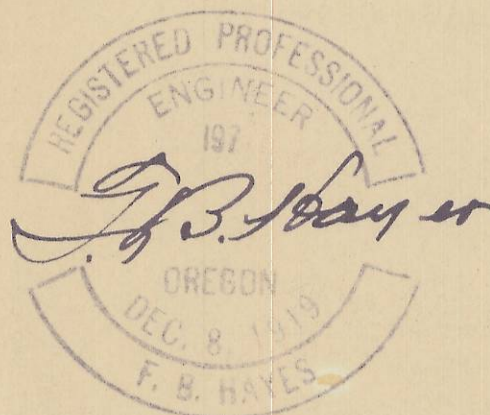

HAYES & HARRIS ENGINEERING

SURVEY FOR
RAYMOND RUGG

WELL LOCATION AND AREA TO BE
IRRIGATED, SEC. 1, T. 2 N., R. 27 E.W.M.

SCALE 1" = 400'	DATE 8/31/54	DRAWN BY m. p. bemis 600
--------------------	-----------------	-----------------------------

no repro avail

Q-1299-R DU 21330

Q-1299