
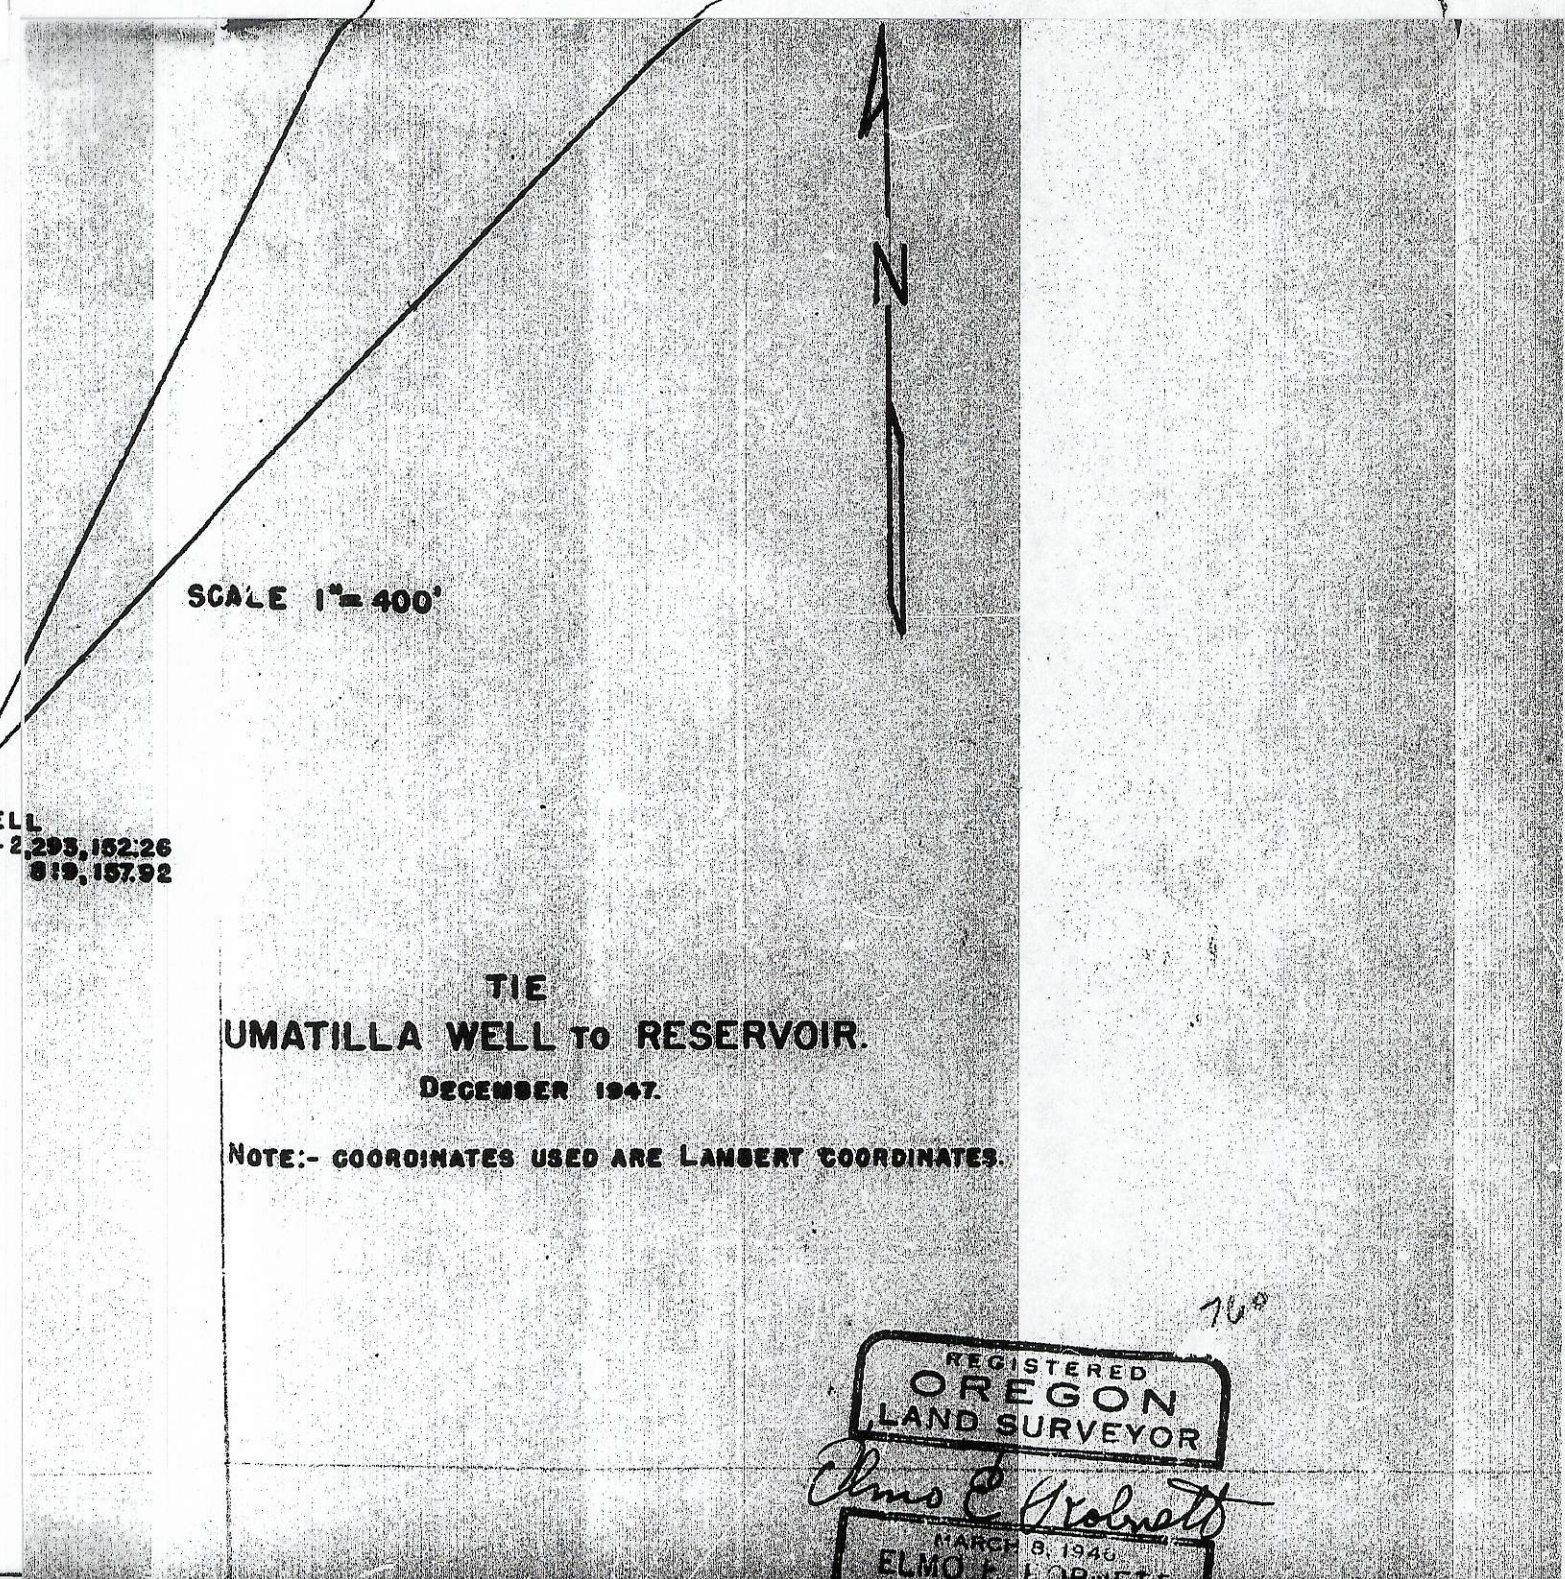


DETAIL OF TIE
OF
WELL FROM RESERVOIR.
SCALE 1" = 20'

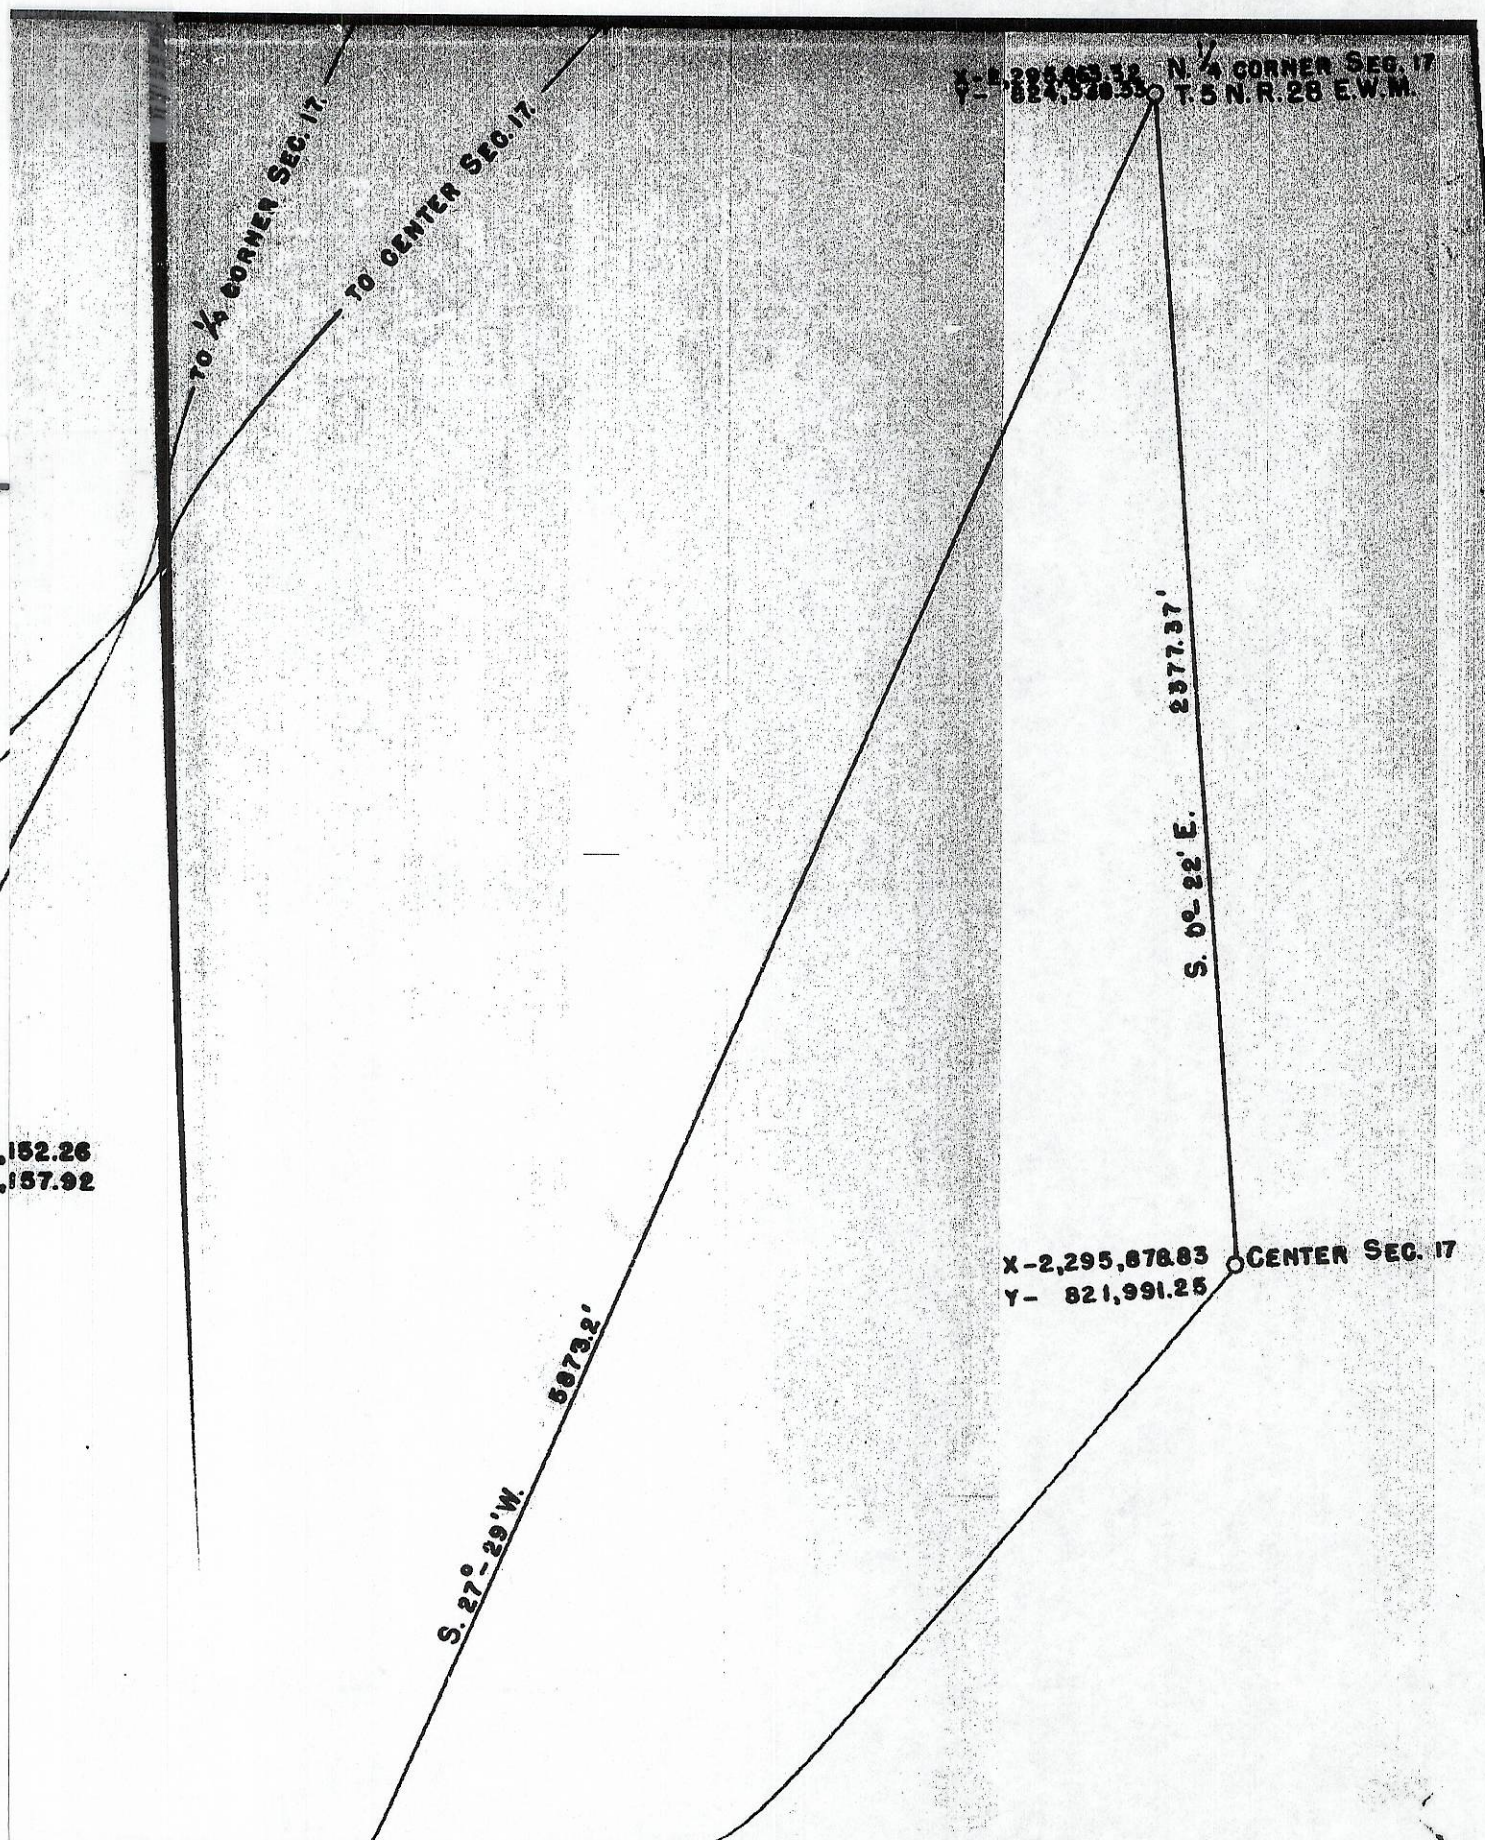

TIE
UMATILLA WELL TO RESERVOIR.
DECEMBER 1947.

NOTE:- COORDINATES USED ARE LAMBERT COORDINATES.

REGISTERED
OREGON
LAND SURVEYOR

Elmo F. Lobnett
MARCH 8, 1948
ELMO F. LOBNETT

760