


BOLCONS STREET

MORROW STREET

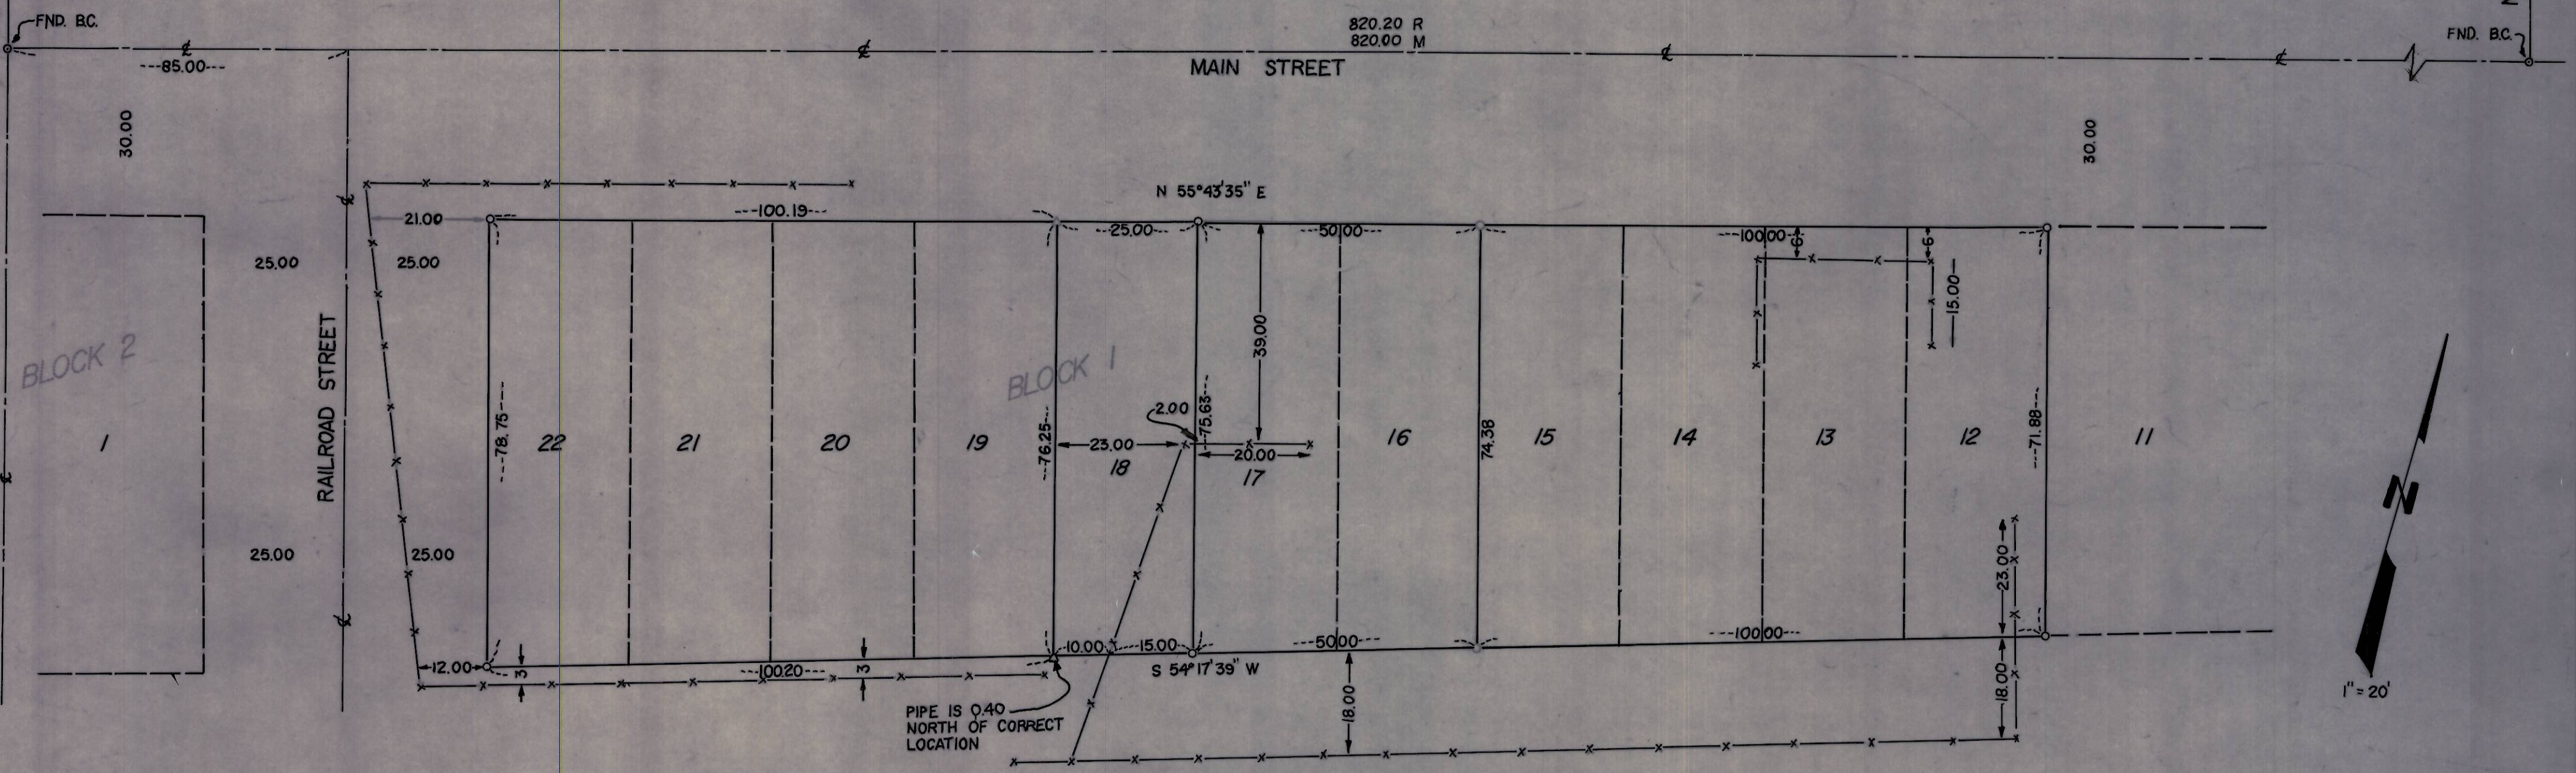

**LEGEND**

- SET 1/2" I. PIN
- △ FND. 3/4" PIPE
- FND. BRASS CAP

**NOTE:**  
 BEARINGS AND DISTANCES BASED  
 ON PLAT OF GEANAKOPOLOS  
 ADDITION TO DORIS.

REGISTERED  
 PROFESSIONAL  
 LAND SURVEYOR  
*David H. Krumbein*  
 OREGON  
 JULY 17, 1950  
 DAVID H. KRUMBEIN  
 833

RECEIVED BY  
 Umatilla County Surveyor  
 Date 5-1-80  
 Rec'd by ELS  
 No. R-80-B

<b>KRUMBEIN ENGINEERING CO.</b> ENGINEERS - SURVEYORS - PLANNERS 216 S.E. 1st, Pendleton, Oregon	SCALE 1" = 20'
	DATE 8-10-76
	SURVEY FOR CASS, SPOUR, & MEACHAM BLOCK 1, GEANAKOPOLOS ADDITION TO DORIS
	T. E. H.
	CHEK BY D. H. K.
	76-47 e