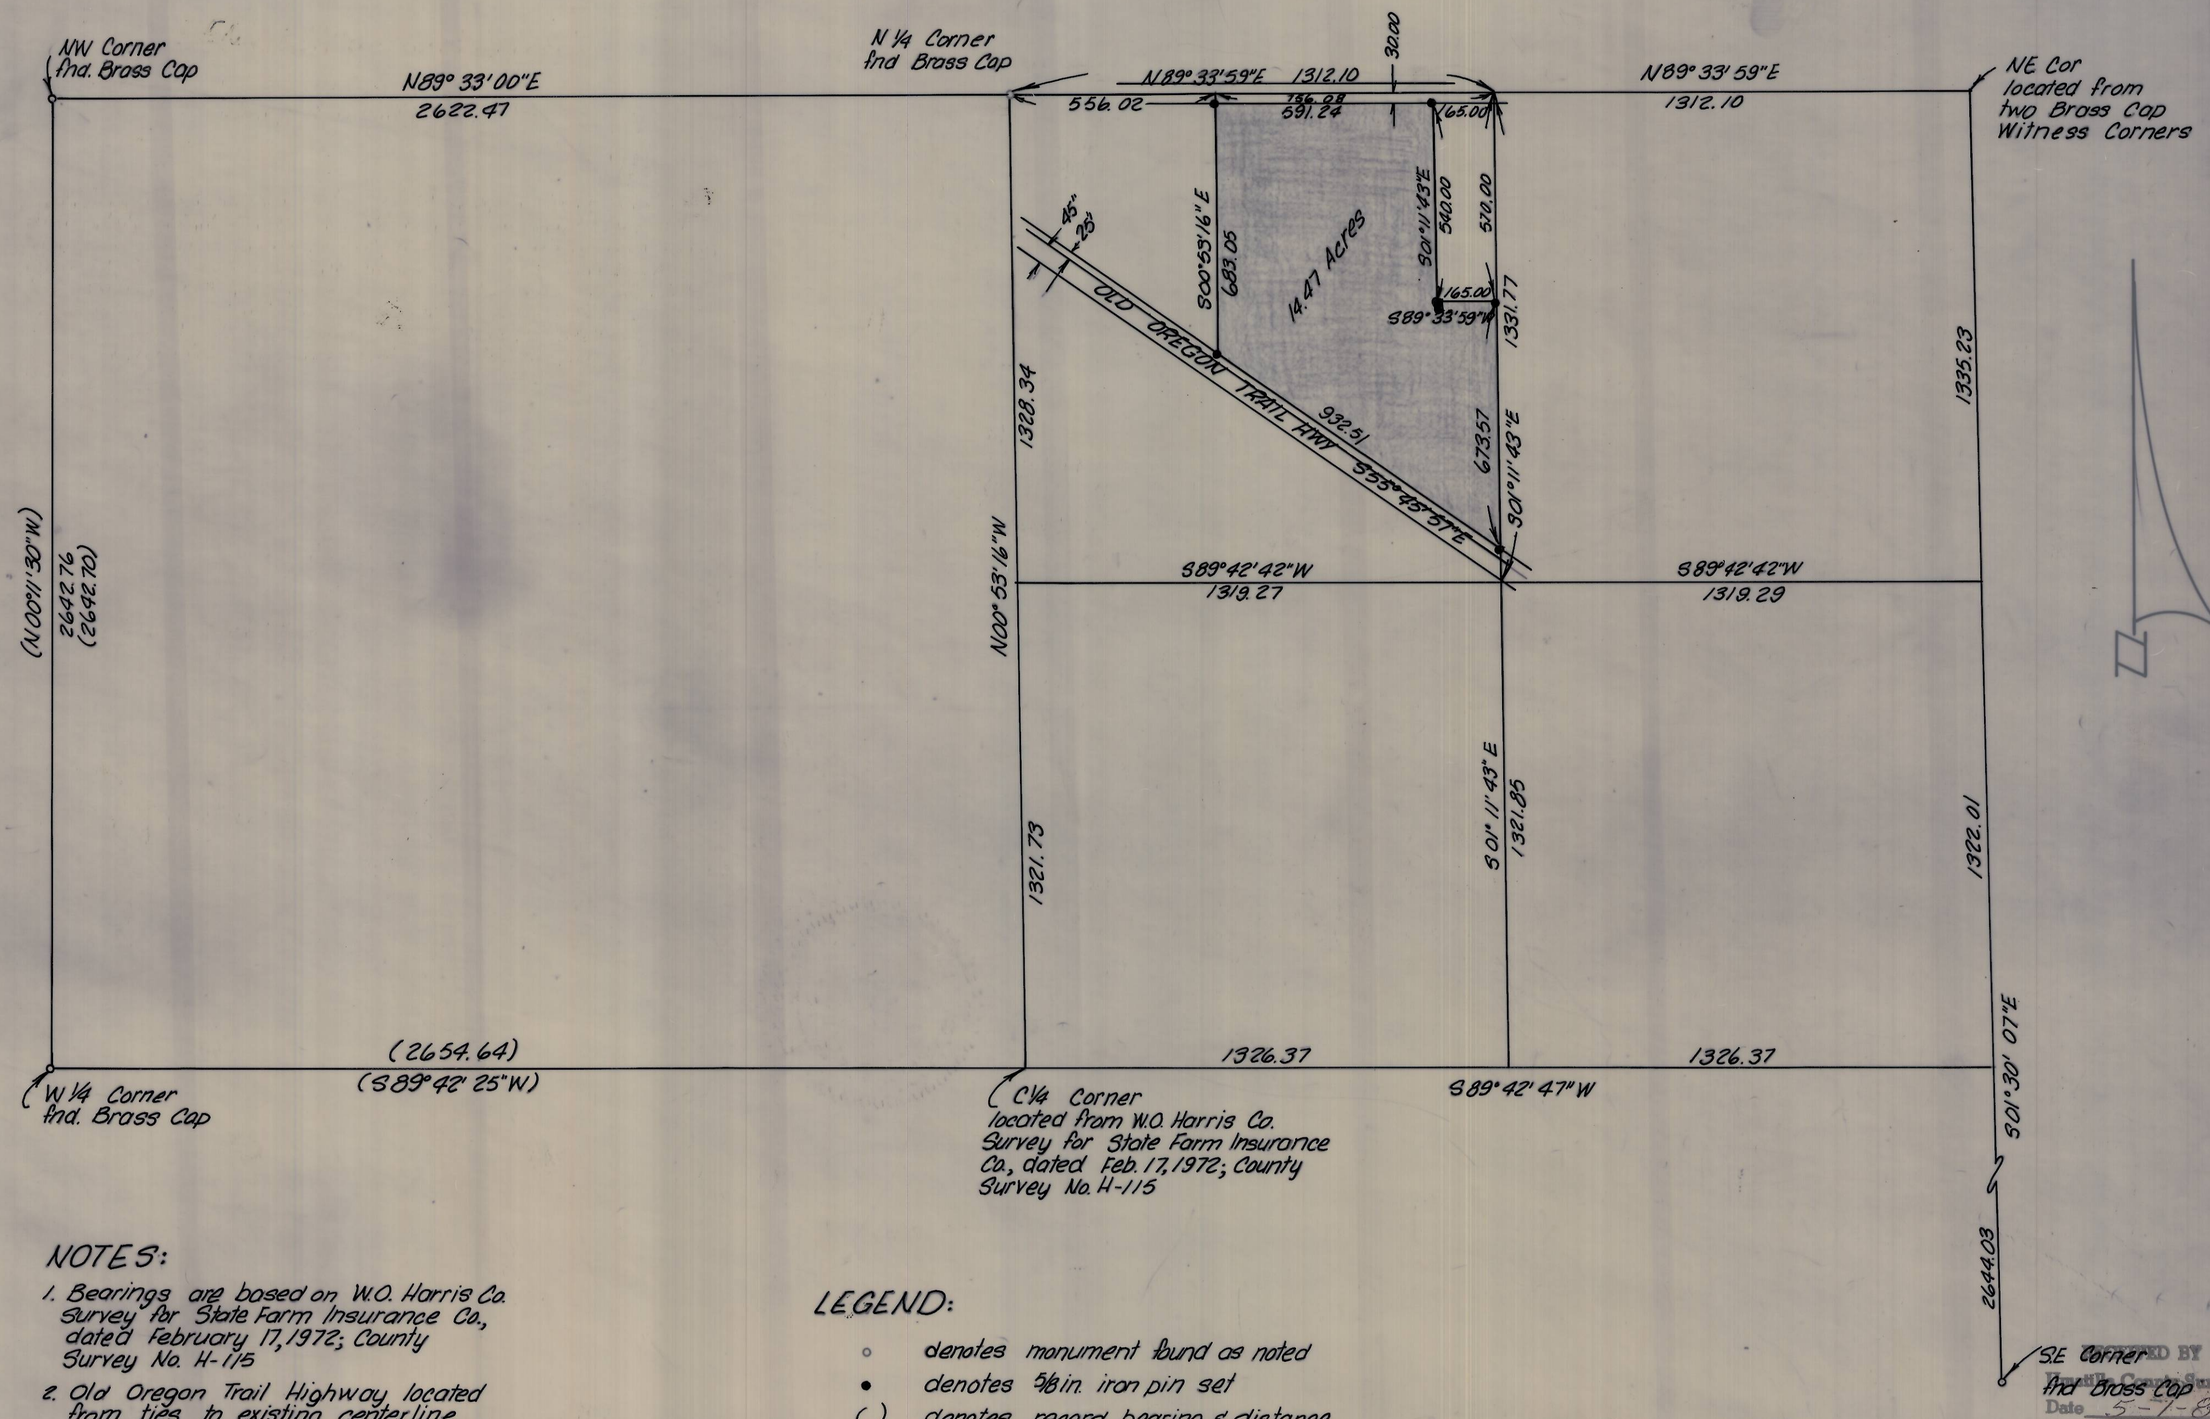

NOTES:

1. Bearings are based on W.O. Harris Co. Survey for State Farm Insurance Co., dated February 17, 1972; County Survey No. H-115
2. Old Oregon Trail Highway located from ties to existing centerline, December 5, 1977, by Krumbein Engineering Co.

LEGEND:

- ○ denotes monument found as noted
- ● denotes 5/8 in. iron pin set
- ( ) denotes record bearing & distance

REGISTERED PROFESSIONAL LAND SURVEYOR
James H. Buisman
OREGON JULY 22, 1977 JAMES H. BUISMAN 1067

RECORDED BY Umatilla County Surveyor
Date 5-1-80
Rec'd By ELS
No. R-93-B

KRUMBEIN ENGINEERING CO.
ENGINEERS – SURVEYORS – PLANNERS
221 S. Main, Pendleton, Oregon

Boundary Survey for
KEITH HUGHES
NW1/4, NE1/4, Section 5, T3N, R29E, W.M.

SCALE 1" = 300'
DATE Apr. 25, 1979
DRN. BY T.A.G.
CKD. BY J.H.B.
DRNG. NO. 79-28C

Job No. 77-332