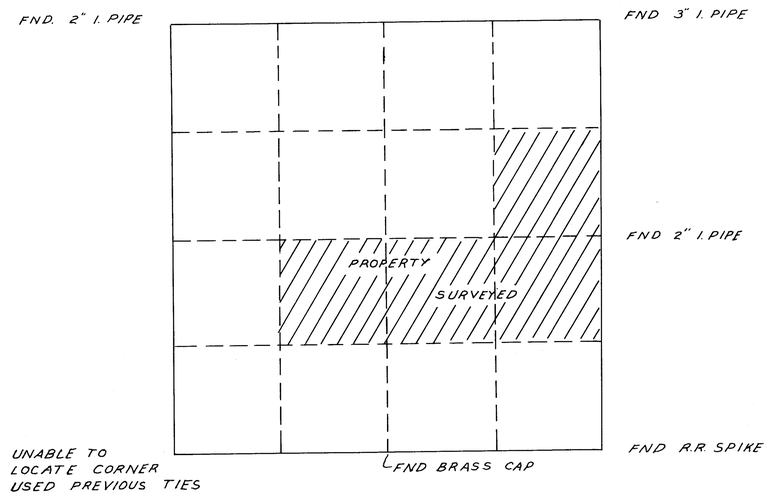

VICINITY MAP
SEC. 15, T 4 N. R. 28 E. W.M
SCALE: 1" = 1000'

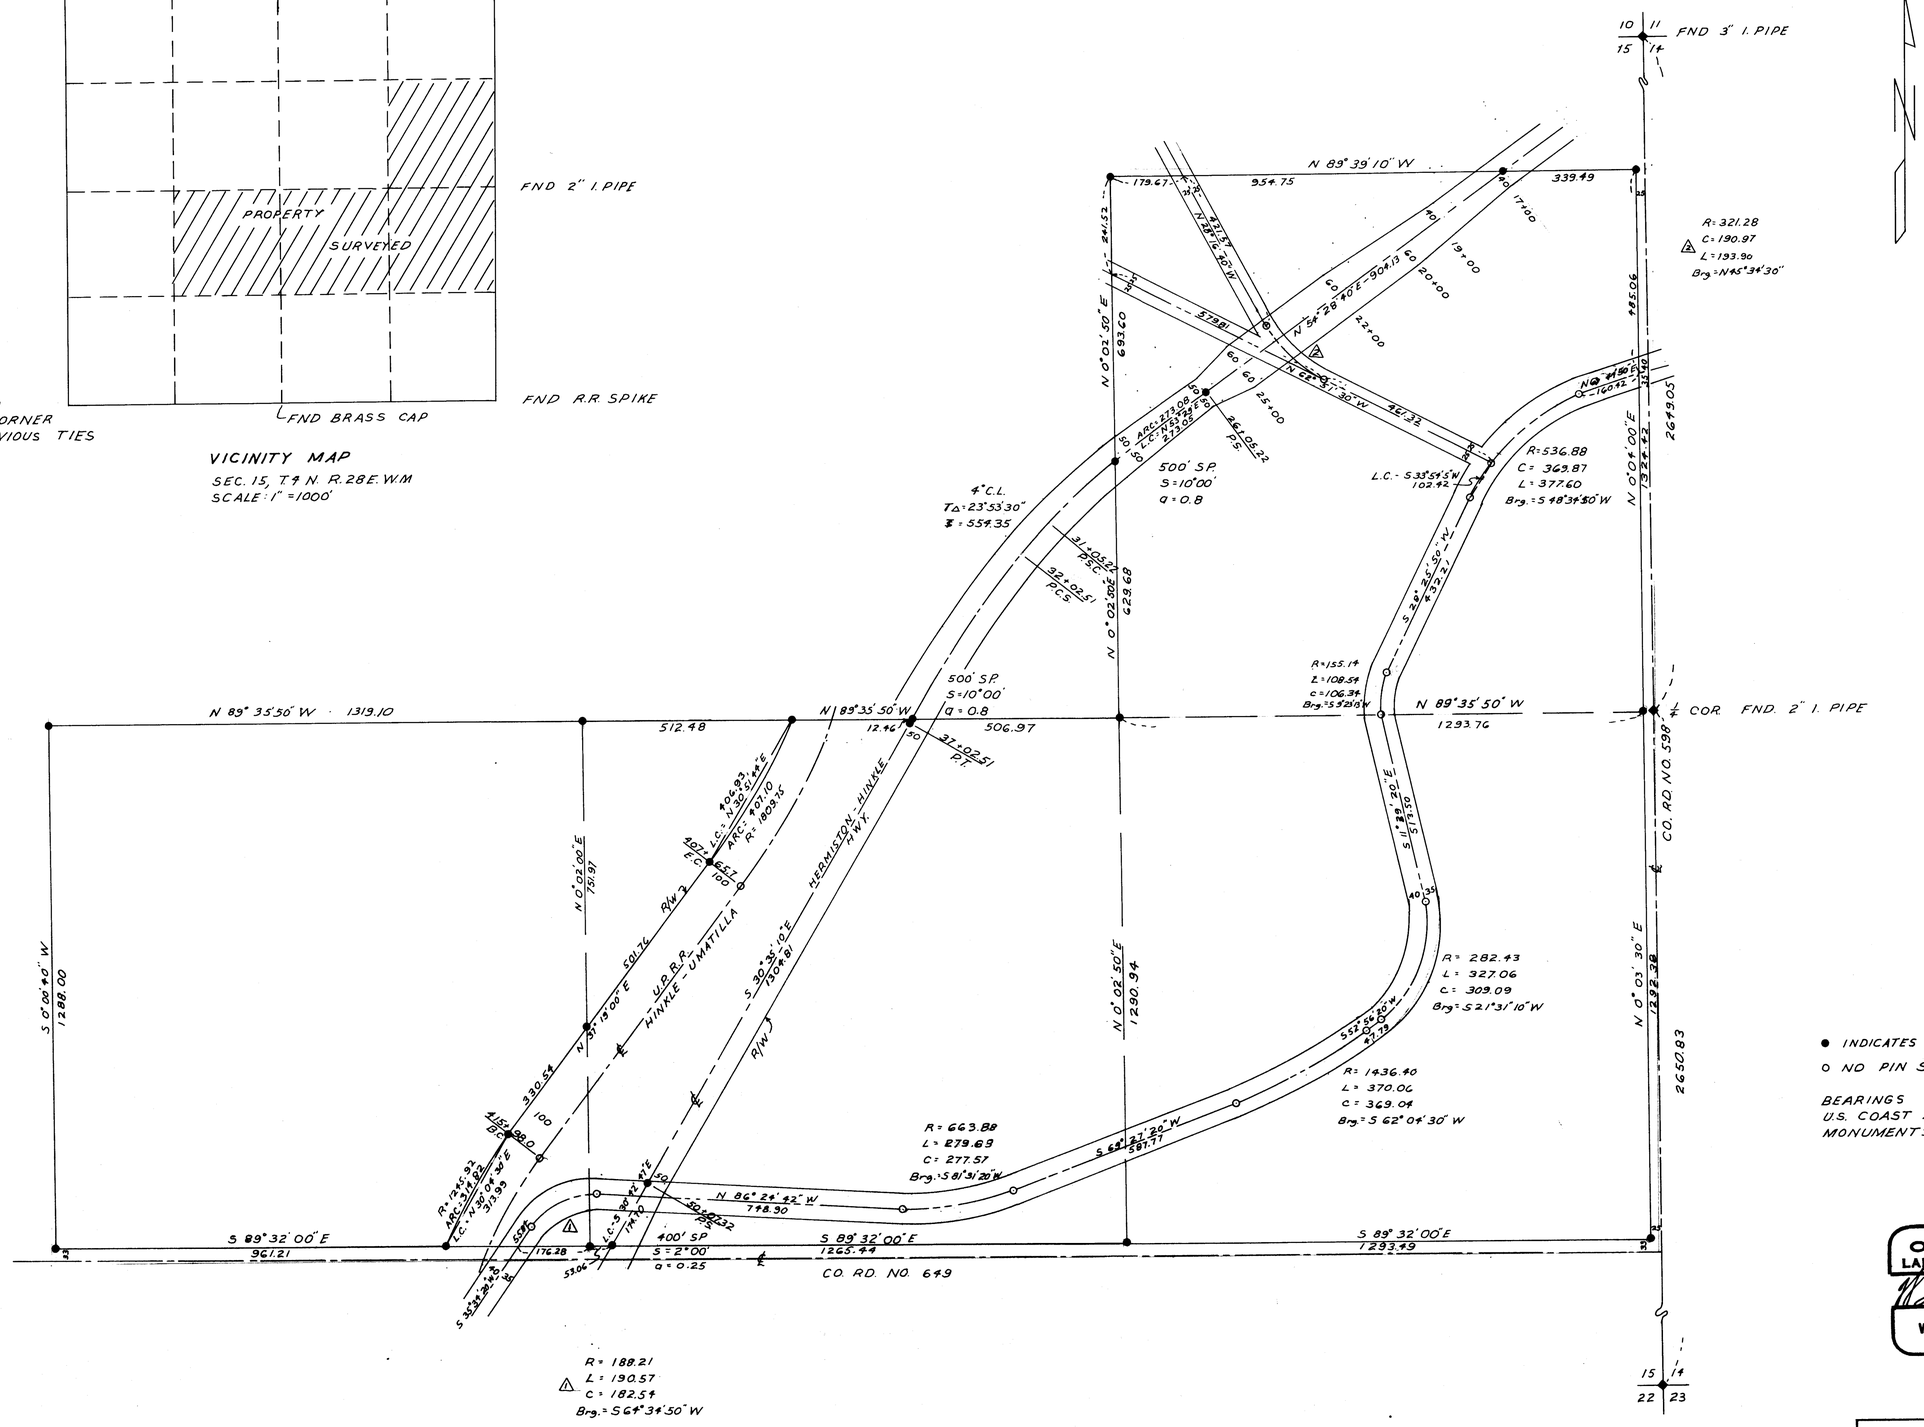

● INDICATES 5/8" I. PIN SET
○ NO PIN SET

BEARINGS BASED UPON TIES TO U.S. COAST AND GEODETIC SURVEY MONUMENTS.

REGISTERED
OREGON
LAND SURVEYOR
MAY 6, 1986
WAYNE O. HARRIS
346

WAYNE O. HARRIS & ASSOCIATES

SURVEY FOR
REUBEN GETTMANN
SEC. 15, T. 4 N., R. 28 E., W.M.

DATE	SCALE	DRN. BY	
SHEET TO	1"=500'	DATE	

03-292-C