


ENGINEERS CERTIFICATE
 I, DONALD L. STAEBLER, Registered Professional Engineer for the State of Oregon, do hereby certify that this map is made from information gathered by an actual field survey and that the surface structures are shown in their true position and that substructures are shown by information taken from other persons and further that this map accurately represents actual conditions to the best of my knowledge and belief.
 Donald L. Staebler

LEGAL DESCRIPTION
 Lot 7 Block 149 of the Reservation Addition to the City of Pendleton, Oregon Excepting therefrom the southerly 10 feet.

- NOTES:**
1. Tank locations have been ascertained by verbal information.
 2. Dimensions are minimal because scale is large enough to plot within one tenth of a foot.
 3. Address is: 1715 S.E. Court Ave. Pendleton, Oregon
 4. Natural Gas lines are approx 30" deep.
 5. Water mains are approx 36" deep.
 6. All streets shown are Asphaltic Concrete (A.C.) pavement.

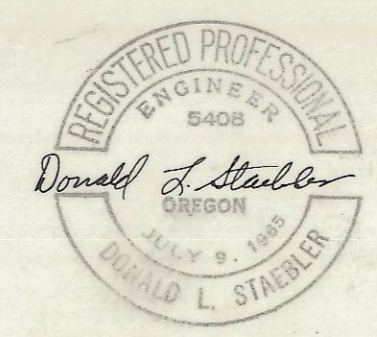

PROJECT: BEELINE LOT SURVEY			
LOT SURVEY FOR BEELINE REFINING Co. OF LOT 7 BLOCK 149 RESERVATION ADDN TO PENDLETON, OREGON			
DR. BY: D.L.S.	DATE: Oct 5, 1965	SCALE: 1" = 6'	
CK. BY:	REV:	SHEET	OF
STANLEY G. WALLULIS Consulting Engineer P.O. Box 91 213 S.W. Emigrant Pendleton Oregon			