CERTIFICATION

I, G. DENNIS EDWARDS A REGISTERED PROFESSIONAL LAND SURVEYOR HEREBY CERTIFY THAT ON 9/25/75 A SURVEY WAS STARTED AND COMPLETED ON 9/30/75 OF THE LANDS SHOWN HEREON BY ME OR UNDER MY DIRECTION THAT THE PROPERTY CORNERS ARE MARKED AS SHOWN, AND THAT THIS MAP IS A TRUE AND ACCURATE REPRESENTATION OF SAID SURVEY.

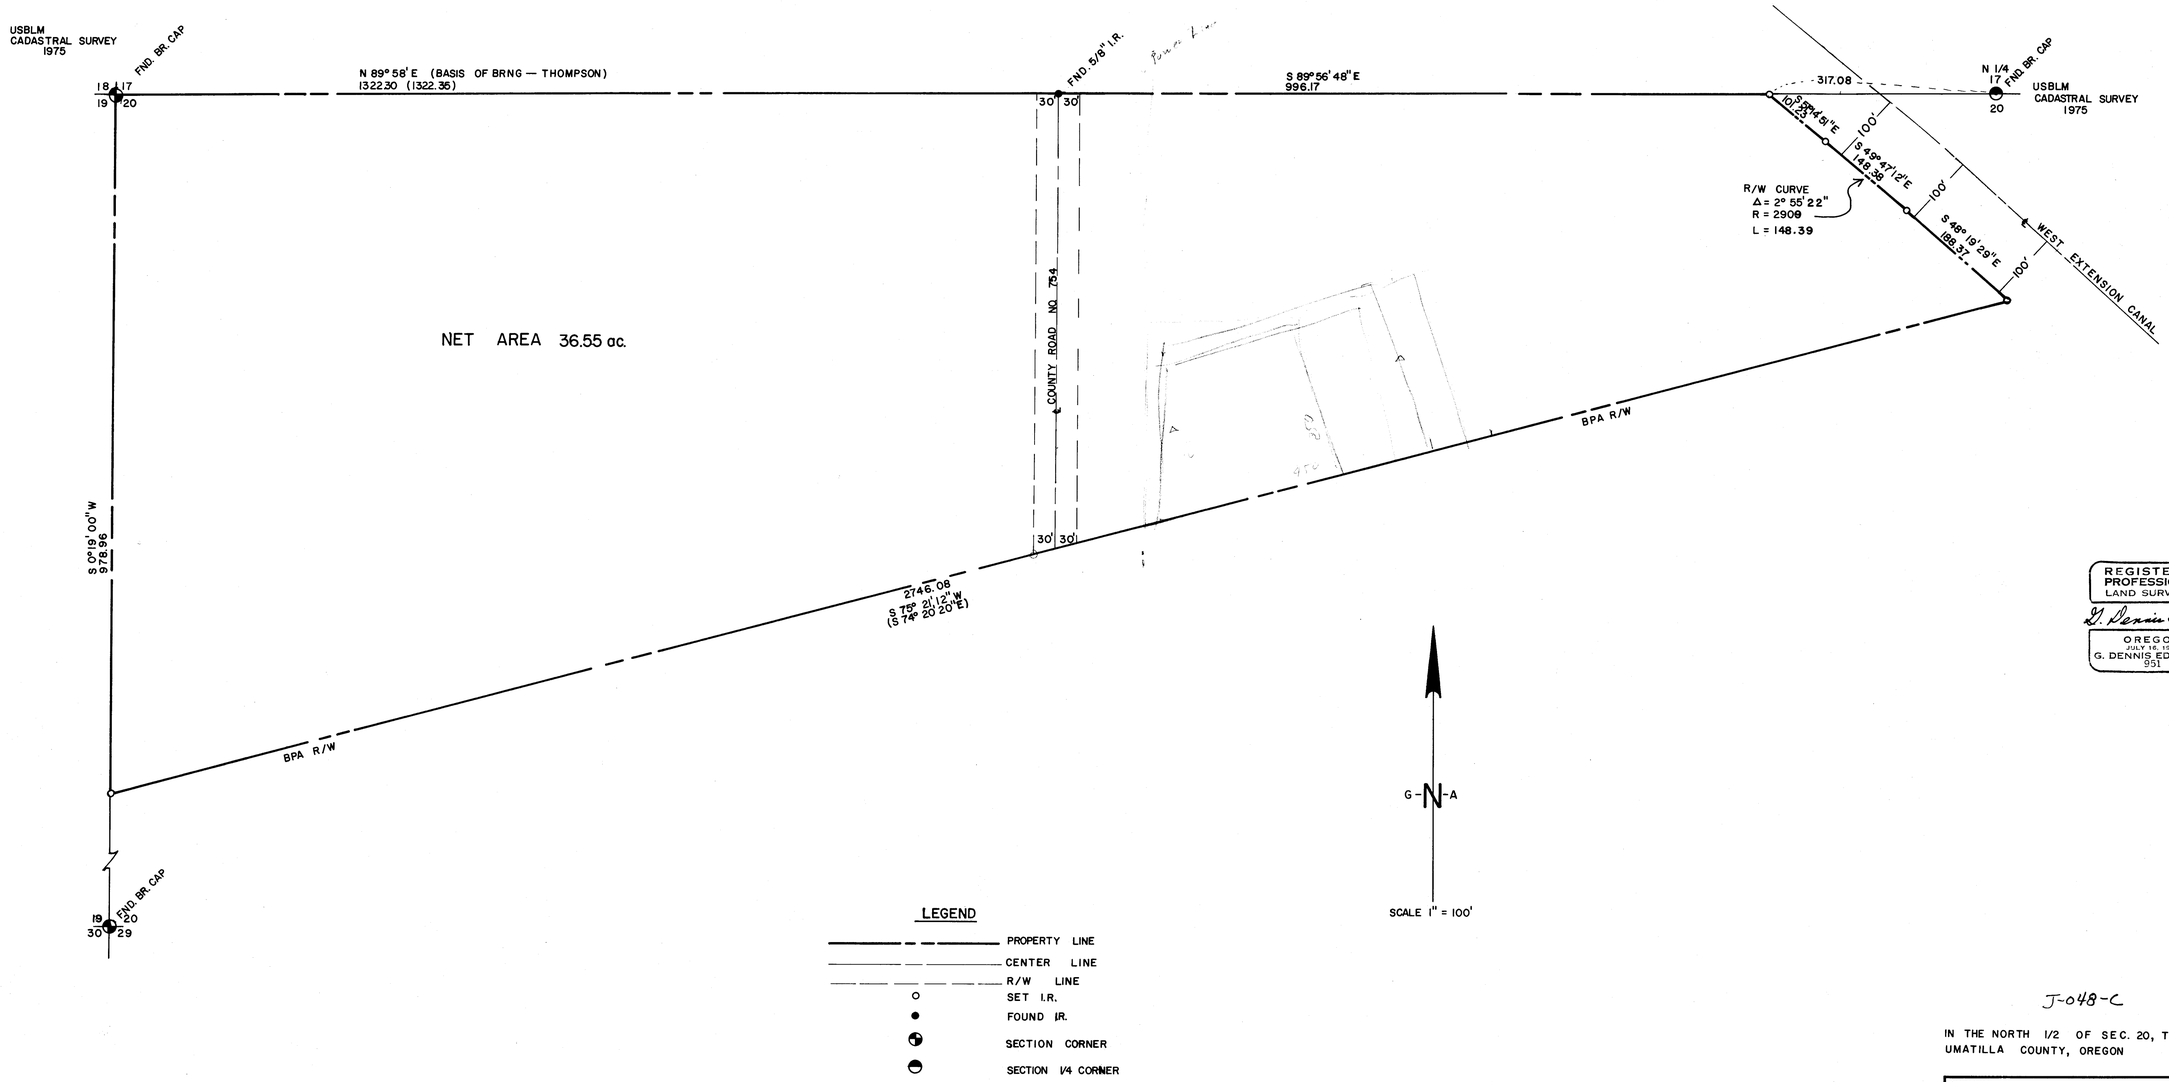

REGISTERED PROFESSIONAL LAND SURVEYOR
G. Dennis Edwards
OREGON
JULY 16, 1971
G. DENNIS EDWARDS
951

J-048-C

IN THE NORTH 1/2 OF SEC. 20, T5N., R.28E., W.M.
UMATILLA COUNTY, OREGON

SURVEY FOR J & A CONFORTH		
GASCHLER & ASSOCIATES ONTARIO, OREGON HERMISTON, OREGON		
DESIGNED BY:	DRAWN BY:	APPROVED BY: G.D.E.
DATE: 10/3/75	DRAWING NO. C-1	BK.____ PG.____
SHEET 1 OF 1	JOB NO. HSO-1375	REVISED:

IDAHO BLUEPRINT & SUPPLY CO., INC., BOISE, IDAHO