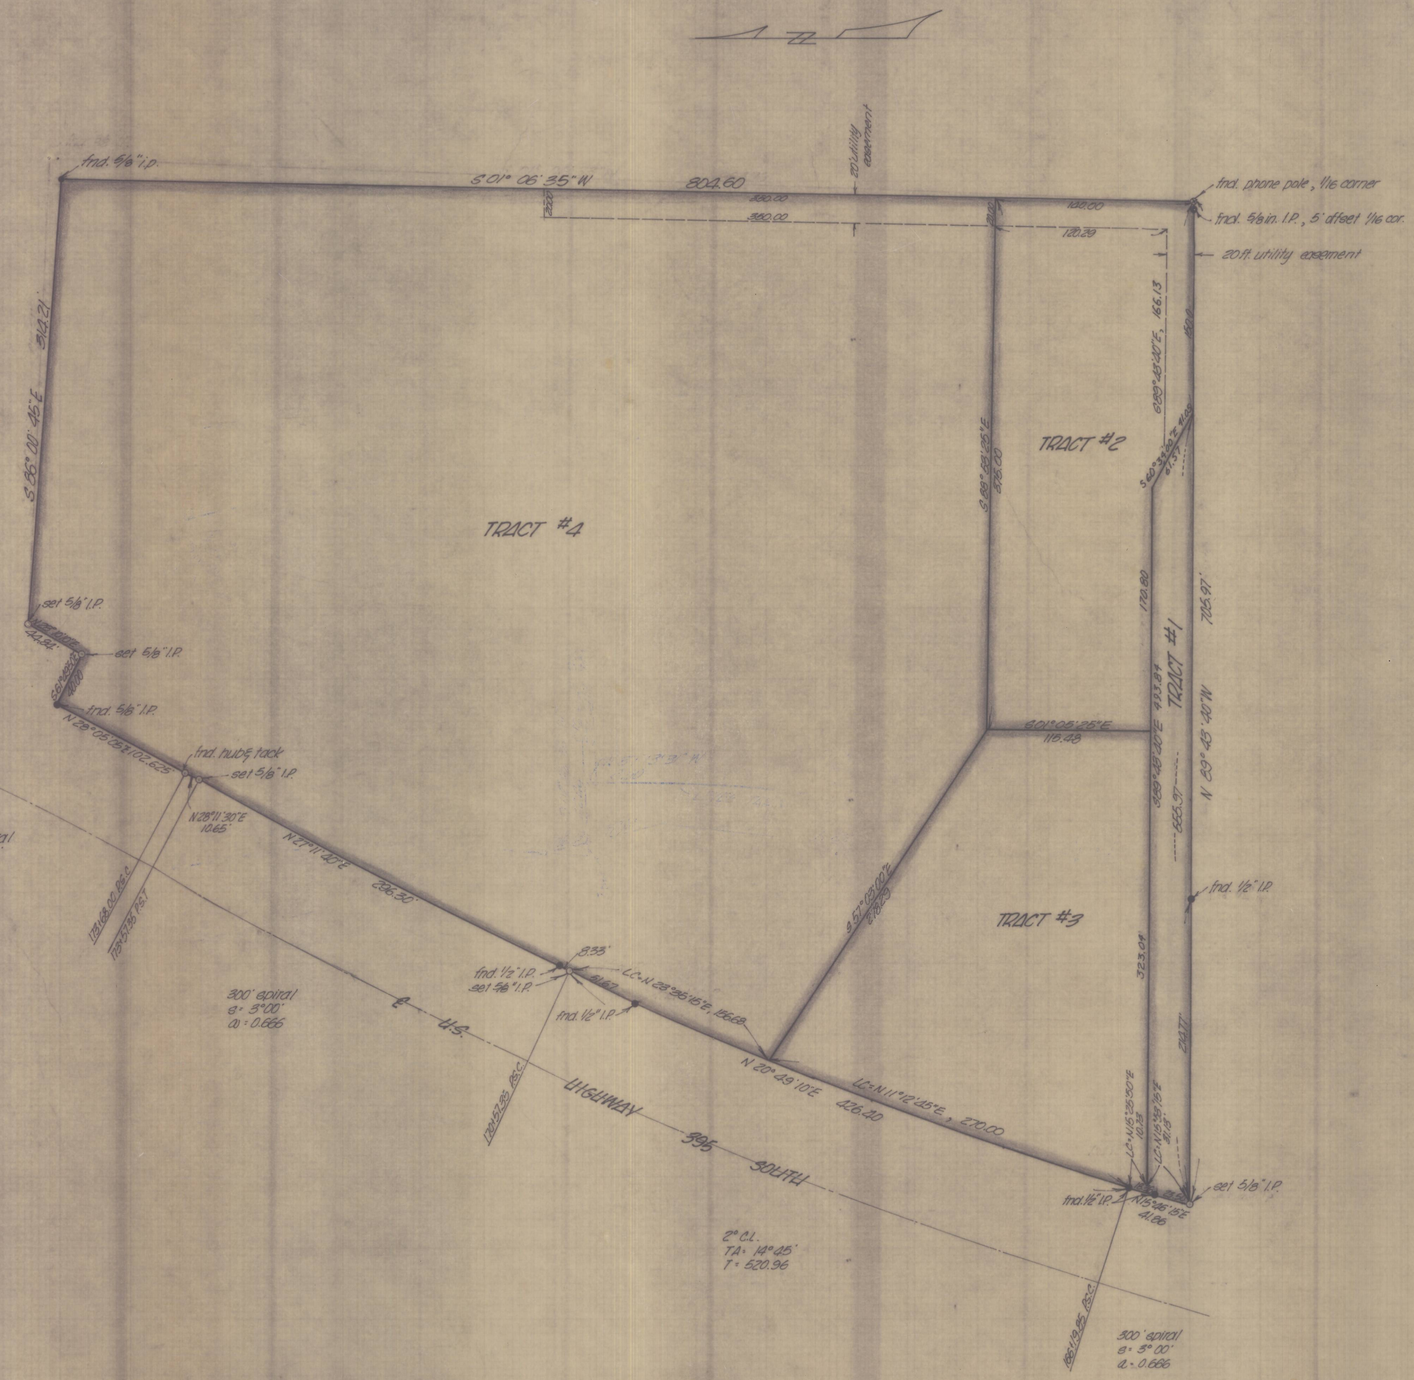

Note:
Bearings & distances are true, based on ties to plat of "Barnum's Addition" to the City of Pendleton, and Wayne Harris survey drawing No. 12-359.

REGISTERED PROFESSIONAL LAND SURVEYOR
OREGON
JULY 17, 1975
DAVID H. KRUMBEIN
933

Revised 5/2/77 JLC.
Revised 4/28/77 DLP

KRUMBEIN ENGINEERING CO.
ENGINEERS – SURVEYORS – PLANNERS
216 S.E. 1st, Pendleton, Oregon

Survey for
"K-MART"
NE ¼, NE ¼, Sec. 16, T. 2 N., R. 32 E., W.M., Pendleton, Or.

SCALE	1"=50'
DATE	Jan. 31, 1977
DRN. BY	JAS.
CKD. BY	DLK
DRNG. NO.	77-110

N-95-C