


- Indicates Monuments Found or Restored as Noted.
- Indicates Set 5/8" x 30" Capped Iron Rod & Steel Post With White Paddle. Alum. Caps Marked "OREGON STATE PARKS"; White Boundary Paddle Marked "OREGON STATE PARK BOUNDARY DO NOT DISTURB". Exceptions Are Noted.

True Bearing Based on Survey of Battle Mountain State Wayside, Sec. 31, T.3S., R. 31 E., W.M. by John E. Hollingsworth, Dated January 22, 1976.

See Narrative For Additional Corner Information.

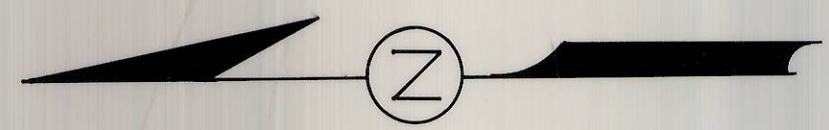

REGISTERED PROFESSIONAL LAND SURVEYOR
 JOHN E. HOLLINGSWORTH
 JULY 9, 1968
 OREGON 691

John E. Hollingsworth

SEC. 20 & 29, T. 3 S., R. 31 E., W.M.
 OREGON STATE PARKS SURVEY
 BATTLE MOUNTAIN STATE PARK & WAYSIDE
 UMATILLA COUNTY
 Scale: 1" = 400' April 14, 1978

0-9-C