

20 21  
29 28

21 22  
28 27 FOUND  
R.R. SPIKE


22 23  
27 26

5351.33  
2675.51

28 27  
SET 1 1/4" I. PIPE  
6" UNDER ROAD

5270.6

27 26  
FOUND CHARCOAL  
SET 2" I. PIPE 6"  
UNDER ROAD

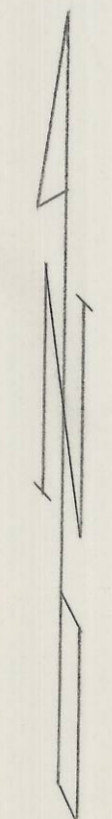

2675.51

28 27 FOUND STONE  
RAISED 3/8" I. PIN  
33 34

REGISTERED  
OREGON  
LAND SURVEYOR  
*Wayne O. Harris*  
MAY 8, 1955  
WAYNE O. HARRIS  
346

HAYES AND HARRIS			
SURVEY FOR			
UMATILLA COUNTY			
SECTION 27			
T.6N., R.35E., W.M.			
SCALE	DATE	DRN. BY	DRNG. NO.
1" = 400'	10-15-62	L. H. A.	62-142-G

A-835-C