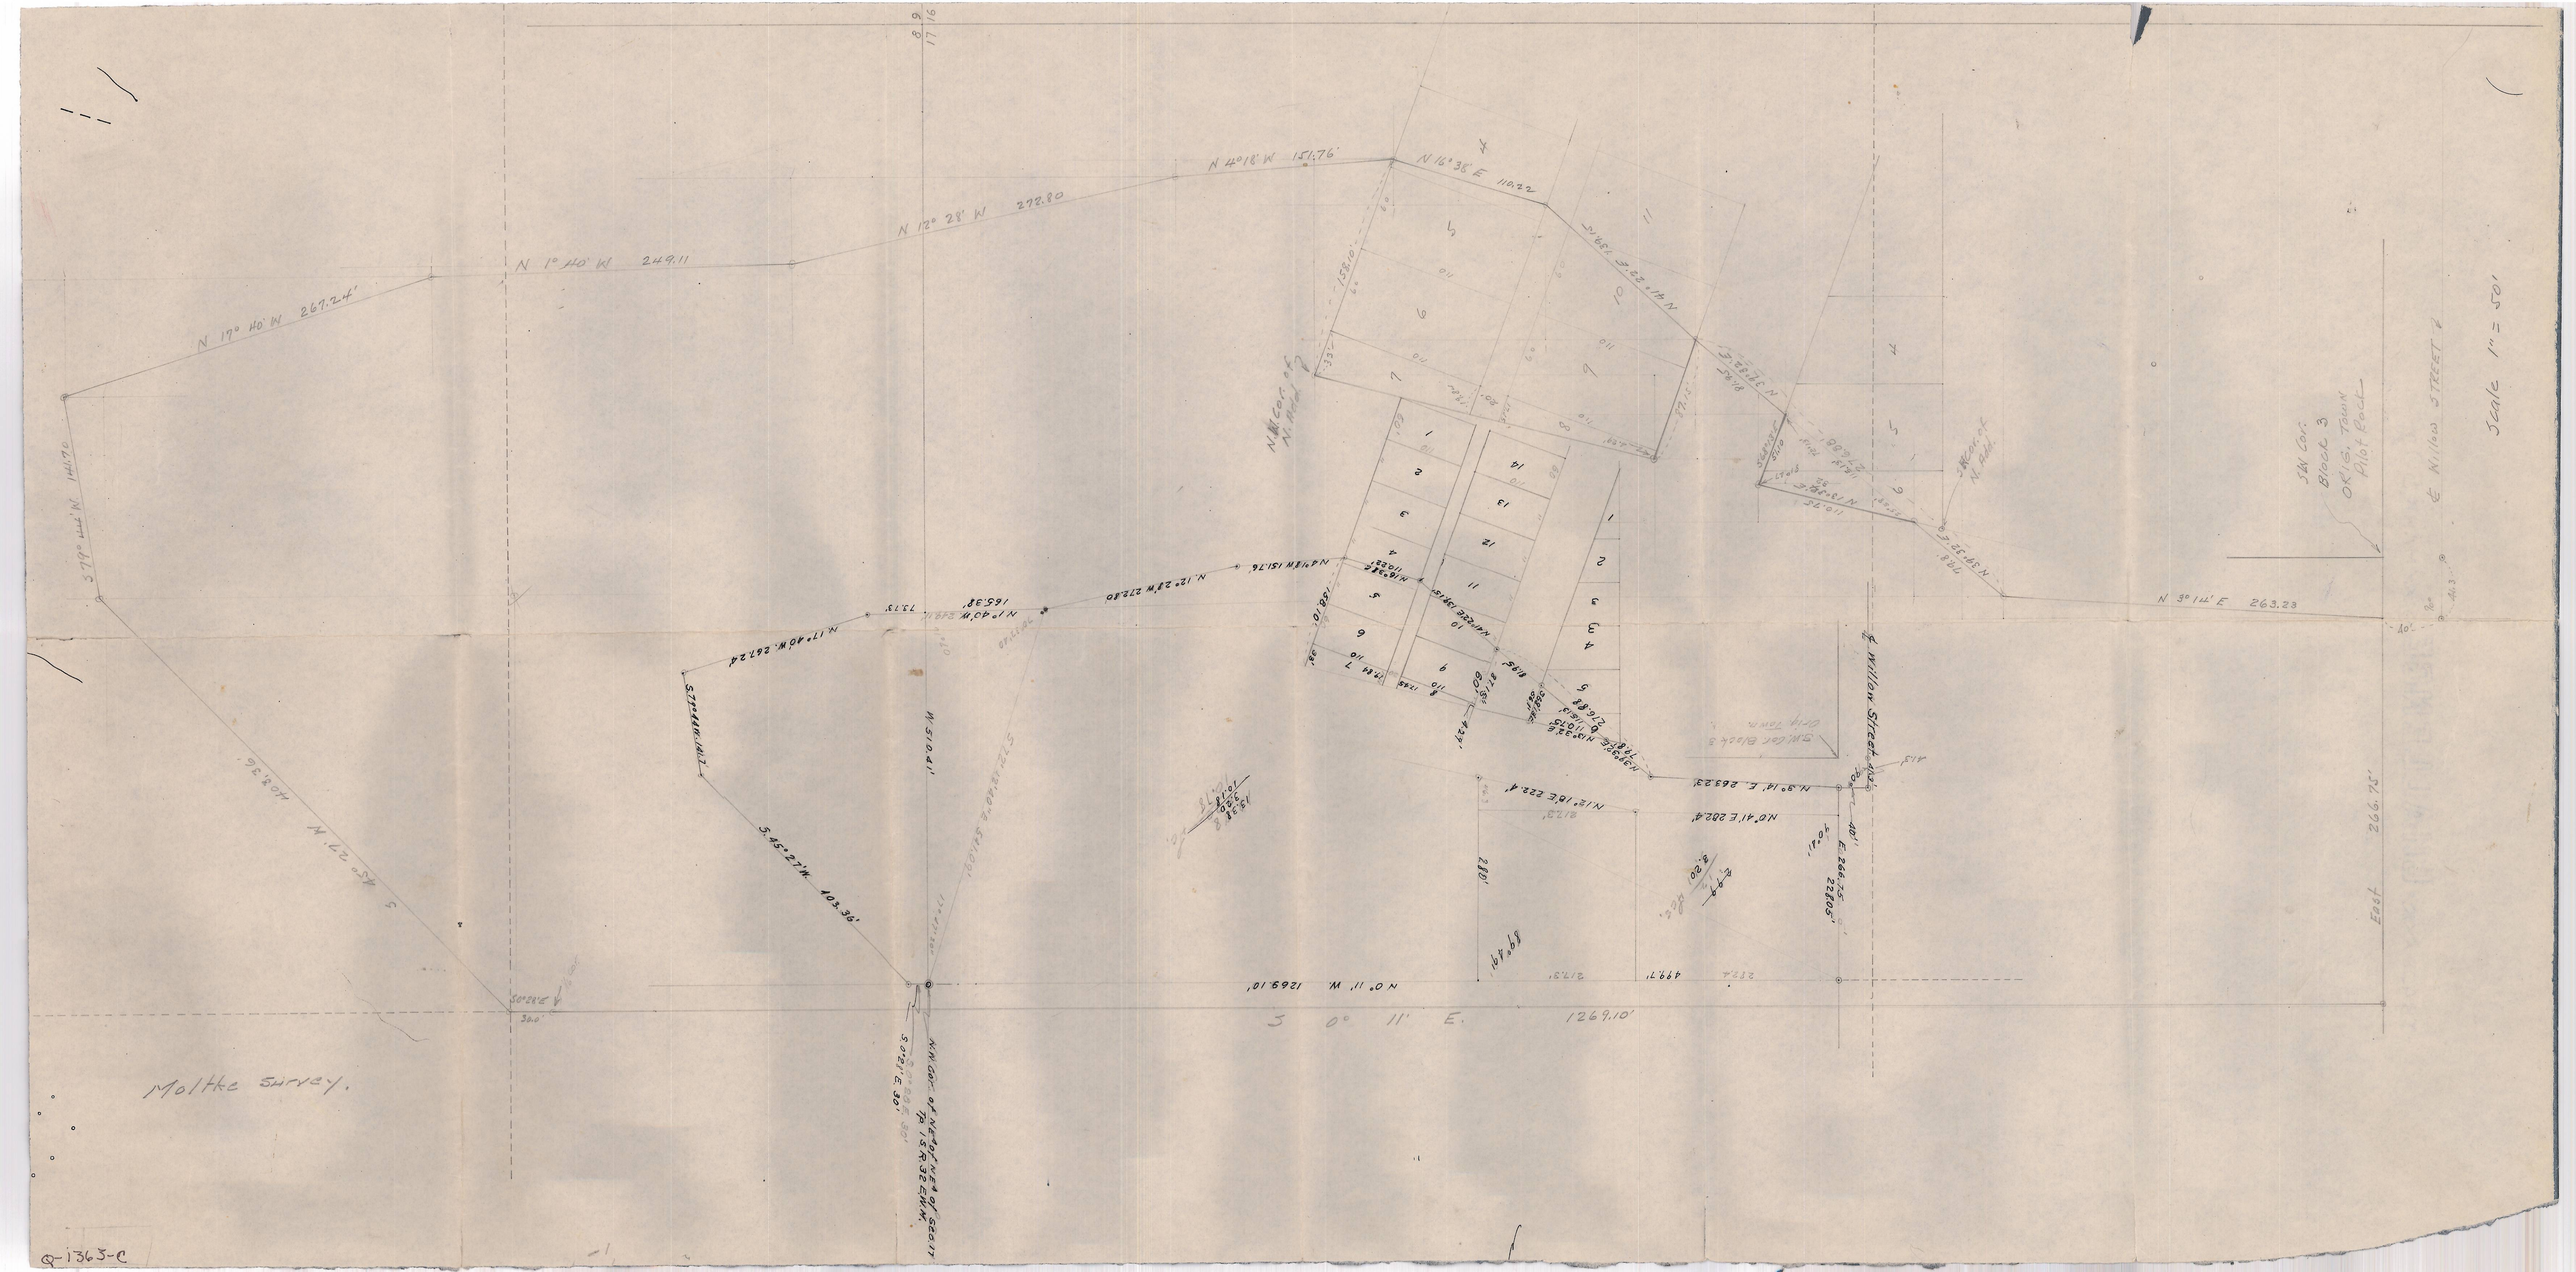

N 17° 40' W 267.24'
N 1° 40' W 249.11
N 12° 28' W 272.80
N 4° 18' W 151.76'
N 16° 38' E 110.22
N 3° 14' E 263.23
S 0° 11' E. 1269.10'
N 0° 11' W 1269.10'
S 45° 27' W 403.36'
S 79° 44' W 141.70
N 41° 22' E 139.15'
N 39° 32' E 79.8'
N 12° 28' W 272.80
N 1° 40' W 249.11
N 17° 40' W 267.24'
N 4° 18' W 151.76'
N 12° 18' E 222.4'
N 0° 41' E 282.4'
N 9° 14' E 263.23'
S 45° 27' W 403.36'
S 79° 44' W 141.70
S 0° 28' E 30.0'
S 0° 21' E 30'
N.W. Cor. of N.E. of N.E. of Sec. 17 Tp. 1 S. R. 32 E.W.M.
N.W. Cor. of N. Add.
S.W. Cor. of N. Add.
S.W. Cor. Block 3 Orig. Town
S.W. Cor. Block 3 Orig. Town Pilot Rock
℄ Willow Street
℄ Willow Street
East 266.75'
Scale 1" = 50'
Moltke Survey.
Q-1363-C