

OREGON CORNER RESTORATION FORM

Section 33 Township 1N Range 31E
 County Umatilla Date: October 4, 2001

Corner Designation: 1N31Z9



South section corner to sections 32 and 33, T1N, R31E, W.M., Umatilla County, Oregon.

Condition Report Only
 Not found
 Remonumented
 Unrecorded
 Surveyed in
 Referenced out

Previous Renewals / Surveys, etc.

The corner was originally set by Josiah Burnett under contract No. 92 dated September 12, 1860. His record reads: Set a post for corner to secs. 32 & 33 drove charred stake & raised mound with trench as per instructions. The County Surveyor, Aubrey Perry, in the survey recorded in Book 2 at Page 301 of the Record of Private Surveys, records: Set rock for Sec. Cor. - 32-33 on N. marke II on W. and III on E..

Monument and Accessories found: (condition and source)
 None: The corner falls in a plowed field.

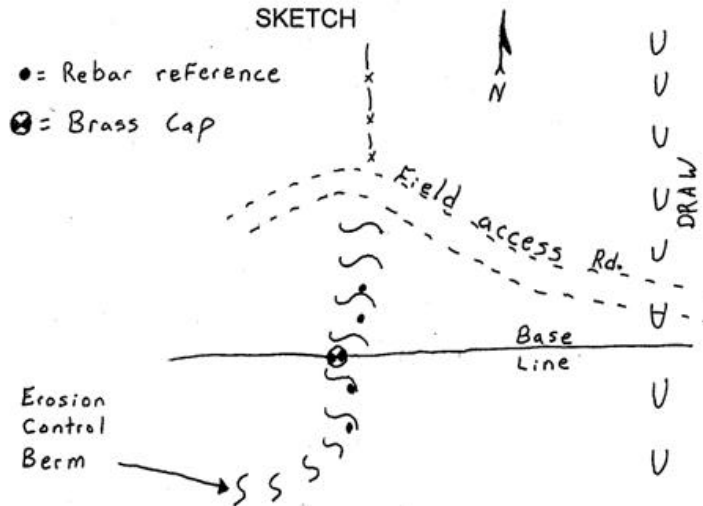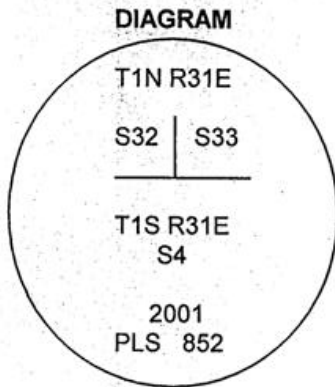

MONUMENT (S) AND ACCESSORIES SET (Procedures and Description)

At the proportionate point I drove a 5/8" x 24" iron rebar into the bedrock 40" below the surface. I cemented a 15" x 1 1/2" G.I.P. with a 2 1/2" brass cap stamped as shown in the diagram above to the rebar. The cap is 24" below the surface on the west side of a field erosion control structure.

For references, I set four 5/8" by 24" rebars with 1 1/4" red plastic caps stamped ORLS 852, and WAL5 13922 as described below:

- an iron rebar bears N27°33'02"E, 26.57 feet, 24" below the surface;
- an iron rebar bears N9°56'31"E, 49.18 feet, 24" below the surface;
- an iron rebar bears S28°04'16"E, 28.53 feet, 24" below the surface;
- an iron rebar bears S23°36'28"E, 53.22 feet, 24" below the surface;

The monument and references were tied using a LIECA SYSTEM 300 RTK GPS.

Location and comments
 OR SPC Oregon North 1983-91
 N = 677891.66
 E = 8598416.29

Compass Declination

Surveyors Seal

RECEIVED BY:
Umatilla County Surveyor
 Date: 12/20/2001
 Rec'd By: D/H/c
 No. 01-206-C

Firm / Agency
 Haddock Surveying
 Address
 P.O. Box 1574
 Pendleton, Or. 97801
 Party Chief
 Stephen K, Haddock



RENEWS 6-30-03