

OREGON CORNER RESTORATION FORM

Section 6 Township 1N Range 32E
 County Umatilla Date: August 20, 2009

Corner Designation: 1N32A3

Common quarter corner to section 31, T2N, R32E and section 6, T1N, R32E, W.M., Umatilla County, Oregon.


Previous Renewals / Surveys, etc.

Corner originally set by David P. Thompson under contract #106 dated August 16, 1864. His record reads: Set post for 1/4 sec. corner in mound of earth with charred stake, pits, & trench.

Monument and Accessories found: (condition and source)

I found decayed wood at the intersection of fences running north, south and west. This wood was probably a decayed fence post, however, this location is the best available evidence of the original corner point.

Condition Report Only
 Not found
 Remonumented
 Unrecorded
 Surveyed in
 Referenced out

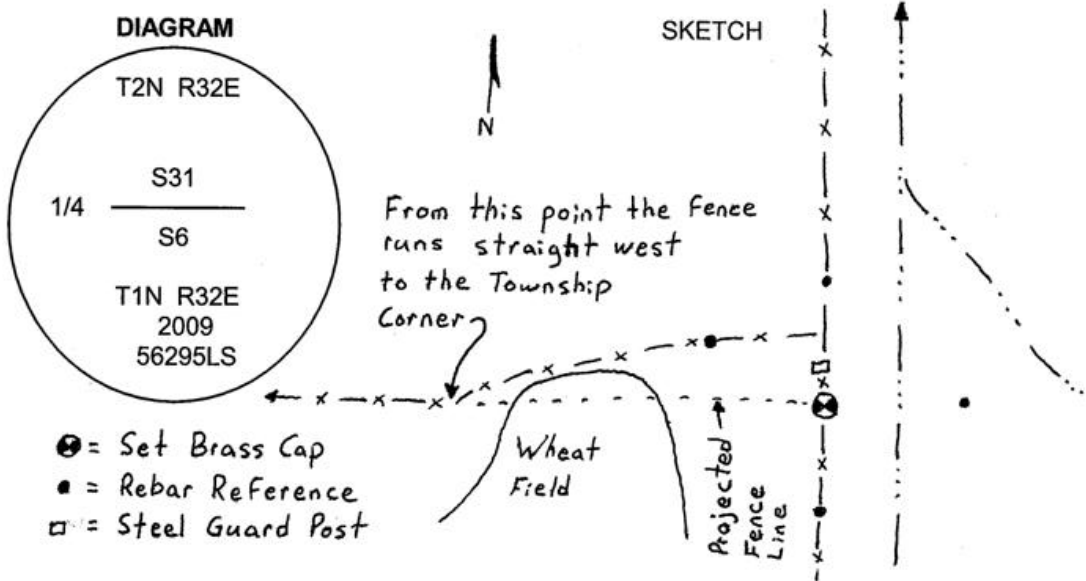

- ⊙ = Set Brass Cap
- = Rebar Reference
- = Steel Guard Post

MONUMENT (S) AND ACCESSORIES SET (Procedures and Description)

I set a 2 1/2" brass cap on a 30" galvanized iron pipe stamped as shown in the diagram above at the intersection of the fences flush with the surface of the ground. I set a 6' steel guard post with a monument sign attached about 1 foot north of the monument.

For references, I set four 5/8" by 24" iron rebars with 1 1/4" orange plastic caps stamped WTS and 56295LS as described below:

- an iron rebar bears N01°14'52"E, 45.41 feet;
- an iron rebar bears S86°23'25"E, 63.98 feet;
- an iron rebar bears S01°46'27"W, 49.31 feet;
- an iron rebar bears N79°05'17"W, 122.55 feet under the existing fence;

The monument and references were tied using a Trimble R7/R8 RTK GPS in static mode.

Location and comments
 NAD 83/1991 State Plane Coordinate
 Oregon North Zone
 N = 709,987.48 ft
 E = 8,622,103.47 ft

Compass Declination
 Firm / Agency
 Witness Tree Surveying
 Address
 P.O. Box G
 Pilot Rock, Or. 97868
 Party Chief
 Stephen K, Haddock

Surveyors Seal

RECEIVED BY:
 Umatilla County Surveyor
 Date: 6-10
 Rec'd By: KK
 No. 10-93C

REGISTERED
 PROFESSIONAL
 LAND SURVEYOR

Stephen K. Haddock

OREGON
 JULY 9, 2001
 STEPHEN K. HADDOCK
 56295LS

RENEWAL DATE 6-30-11