

OREGON CORNER RESTORATION FORM

Section 3 Township 1N Range 32E
County Umatilla Date: April 1, 2010

Corner Designation: 1N32C17

- Condition Report Only
- Not found
- Remonumented
- Unrecorded
- Surveyed in
- Referenced out

Quarter corner common to sections 2 and 3,
T1N, R32E, W.M., Umatilla County, Oregon.


Previous Renewals / Surveys, etc.

Corner originally set by Daniel Chaplin under contract No. 107 dated September 21, 1864.
His record reads: Set post for 1/4 section corner from which a cotton wood, 10ins. daim., bears N. 75° W. 34 lks. dist. A cotton wood, 18 ins. diam., bears N.15° E. 96 lks. dist. Zenas F. Moody under contract No. 164 dated October 4, 1871, stated: Set post with two bearing trees. Currin and Noland under special contract dated May 4, 1887, stated: Set basalt stone 8 x 10 x 14 ins. with one bearing tree.

Monument and Accessories found: (condition and source)
None. This point falls in the McKay Reservoir.

DIAGRAM

SKETCH

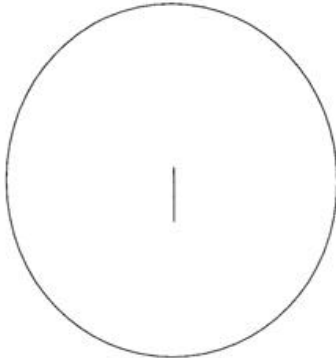

MONUMENT (S) AND ACCESSORIES SET (Procedures and Description)
None. This is a calculated position only and is calculated to provide the state plane coordinates of the corner point.

For references:

Location and comments
NAD 83/1991 State Plane Coordinate
Oregon North Zone
N = 707,565.75 ift
E = 8,640,615.58 ift

Compass Declination

Surveyors Seal

RECEIVED BY:
Umatilla County Surveyor
Date: 6-16
Rec'd By: KK
No. 10-93-C

Firm / Agency
Witness Tree Surveying
Address
P.O. Box G
Pilot Rock, Or 97868
Party Chief
Stephen K, Haddock

REGISTERED
PROFESSIONAL
LAND SURVEYOR

Stephen K. Haddock

OREGON
JULY 9, 2001
STEPHEN K. HADDOCK
56295LS

RENEWAL DATE 6-30-11