


**OREGON CORNER RESTORATION FORM**

Section 1 Township 1N Range 32E  
 County Umatilla Date: July 1, 2009

Corner Designation: 1N32C21 Condition Report Only  
 Not found  
x Remonumented  
 Unrecorded  
x Surveyed in  
x Referenced out

Previous Renewals / Surveys, etc.  
 Corner originally set by Daniel Chaplin under contract No. 107, dated September 21, 1864. His record reads: Set post for 1/4 section corner in mound of earth with charred stake, pits, etc., as per instructions. Zenas F. Moody under contract No. 164, dated October 4, 1871, stated: Set post. Currin and Noland under special contract dated May 4, 1887, stated: Set stone 7 x 8 x 9 ins. The McKay Refuge survey, H-254-B states: Road centerline n, s, e, and fence corner west.  
 Monument and Accessories found: ( condition and source )  
 None. I held the point determined in suvey H-9-B which is the centerline of the road and the south line of that tract survey.

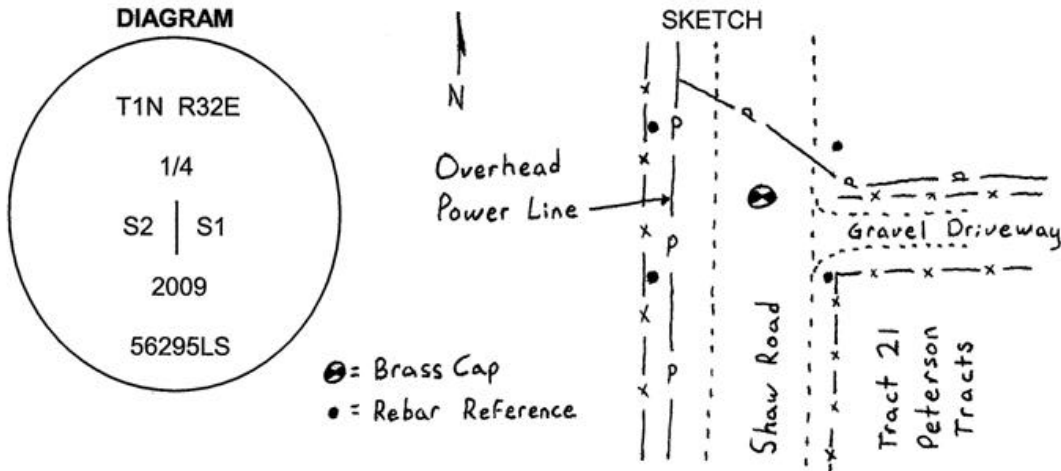

**MONUMENT (S) AND ACCESSORIES SET (Procedures and Description)**  
 Set a 1 1/2" x 30" Galvanized Iron Pipe with a 2 1/2" brass cap stamped a shown in the diagram above. The cap is 6" below the surface of the road.

For references, I set four 5/8" by 24" iron rebars with 1 1/4" orange plastic caps stamped WTS and 56295LS, as described below:  
 an iron rebar bears N33°44'05"W, 33.86 feet;  
 an iron rebar bears N34°29'22"E, 34.44 feet 12 inches below the surface;  
 an iron rebar bears S29°06'58"E, 51.47 feet;  
 an iron rebar bears S23°01'12"W, 49.37 feet;

This monument was set and references tied using a Trimble R7/R8 RTK GPS.

Location and comments  
 NAD 83/1991 State Plane Coordinate  
 Oregon North Zone  
 N = 707,624.82 ift  
 E = 8,645,886.20 ift

Compass Declination

Firm / Agency  
 Witness Tree Surveying  
 Address  
 P.O. Box G  
 Pilot Rock, Or. 97868  
 Party Chief  
 Stephen K. Haddock

RECEIVED BY:  
Umatilla County Surveyor  
 Date: 6-10  
 Rec'd By: KK  
 No. 10-93-C

Surveyor's Seal

**REGISTERED PROFESSIONAL LAND SURVEYOR**

*Stephen K. Haddock*

OREGON  
 JULY 9, 2001  
**STEPHEN K. HADDOCK**  
 56295LS

RENEWAL DATE 6-30-11