

OREGON CORNER RESTORATION FORM

Section 3 Township 1N Range 32E
County Umatilla Date: July 26, 2009

Corner Designation: 1N32E15

Quarter corner common to sections 3 and 10, T1N, R32E,
W.M., Umatilla County, Oregon.

Condition Report Only
 Not found
 Remonumented
 Unrecorded
 Surveyed in
 Referenced out


Previous Renewals / Surveys, etc.

Corner originally set by Daniel Chaplin under contract No. 107 dated September 21, 1864.
His record reads: Set post for 1/4 sec. cor. in mound of earth with charred stake, pits &c as per instructions. Zenas F. Moody under contract No. 164, dated October 4, 1871; stated: Set post. Currin and Noland under Special Contact dated May 4, 1887, stated: Set Post in mound. David L. Haddock, in survey 05-150-B states: Set Brass Cap.

Monument and Accessories found: (condition and source)
I found the brass cap by Haddock in good condition as described.

DIAGRAM

SKETCH

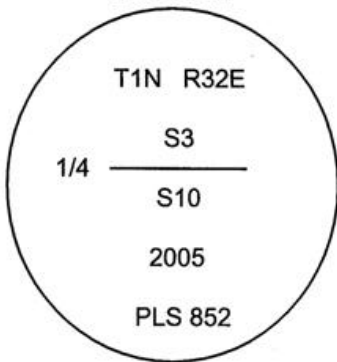

MONUMENT (S) AND ACCESSORIES SET (Procedures and Description)
None. This certificate is recorded to report the State Plane Coordinate for this corner.

The monument was tied using a Trimble R7/R8 RTK GPS system.

Location and comments
NAD 83/1991 State Plane Coordinate
Oregon North Zone
N = 704,871.87 ift
E = 8,638,028.57 ift

Compass Declination

Surveyors Seal

RECEIVED BY:
Umatilla County Surveyor
Date: 6-10
Rec'd By: KF
No. 10-93-C

Firm / Agency
Witness Tree Surveying
Address
P.O. Box G
Pilot Rock, Or. 97868
Party Chief
Stephen K, Haddock

REGISTERED
PROFESSIONAL
LAND SURVEYOR

Stephen K. Haddock

OREGON
JULY 9, 2001
STEPHEN K. HADDOCK
56295LS

RENEWAL DATE 6-30-11