

**OREGON CORNER RESTORATION FORM**

Section 6 Township 1N Range 32E  
 County Umatilla Date: August 20, 2009

Corner Designation: 1N32E5

Corner common to sections 5, 6, 7, and 8, T1N, R32E, W.M., Umatilla County, Oregon.


Condition Report Only  
 Not found  
 Remonumented  
 Unrecorded  
 Surveyed in  
 Referenced out

Previous Renewals / Surveys, etc.

This corner was originally set by Daniel Chaplin under contract No. 107 dated September 21, 1864. His record reads: Set post for corner to secs 5, 6, 7 and 8 in mound of earth with charred stake, pits &c as per instructions. L. E. Macomber, under survey in the Record of Private Surveys, Book 1, Page 471 says found an old wagon skein.

Monument and Accessories found: ( condition and source )

None. I held the intersection of fences to the East and South as the best available evidence.

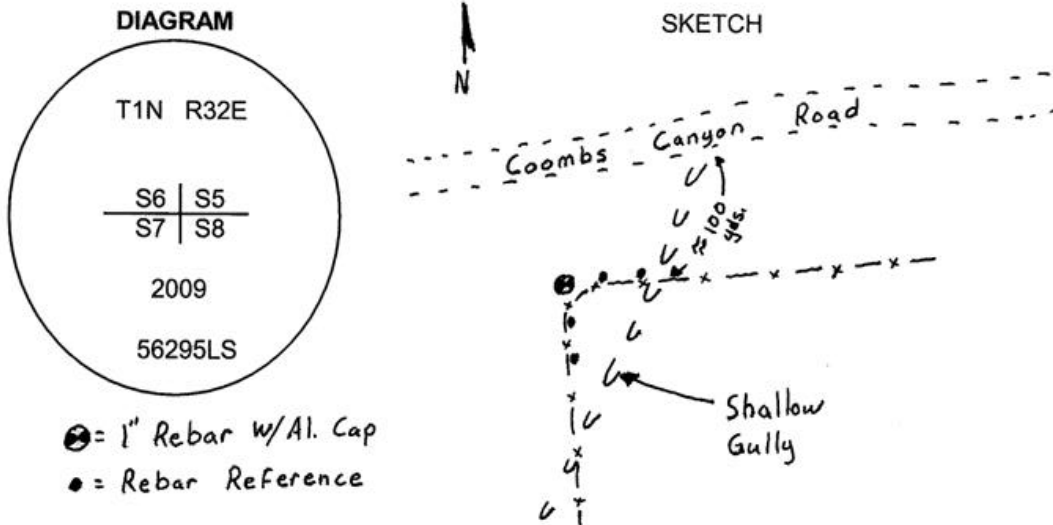

**MONUMENT (S) AND ACCESSORIES SET (Procedures and Description)**

Set a 1" x 18" iron rebar with a 2" aluminum cap. I drove the rebar 15" into bedrock. The cap is 22" below the surface.

For references, I set four, 5/8" by 24" iron rebars with 1 1/4" orange plastic caps stamped WTS and 56295LS as described below:

- an iron rebar bears S88°55'10"E, 23.31 feet under the existing fence;
- an iron rebar bears S89°48'29"E, 85.92 feet under the existing fence;
- an iron rebar bears S0°31'21"W, 49.67 feet under the existing fence;
- an iron rebar bears S0°24'31"W, 82.94 feet under the existing fence;

The monument and references were tied using a Trimble R7/R8 RTK GPS.

Location and comments  
 NAD 83/1991 State Plane Coordinate  
 Oregon North Zone  
 N = 704,602.73 ift  
 E = 8,624,890.74 ift

Compass Declination  
 Firm / Agency  
 Witness Tree Surveying  
 Address  
 P.O. Box G  
 Pilot Rock, Or. 97868  
 Party Chief  
 Stephen K, Haddock

Surveyors Seal

RECEIVED BY:  
Umatilla County Surveyor  
 Date: 6-10  
 Rec'd By: KK  
 No. 10-93-C

REGISTERED  
 PROFESSIONAL  
 LAND SURVEYOR

*Stephen K. Haddock*

OREGON  
 JULY 9, 2001  
 STEPHEN K. HADDOCK  
 56295LS

RENEWAL DATE 6-30-11