


OREGON CORNER RESTORATION FORM

Section 8 Township 1N Range 32E
 County Umatilla Date: August 31, 2009

Corner Designation: 1N32G9
 Condition Report Only
 Not found
x Remonumented
 Unrecorded
 Surveyed in
x Referenced out

Previous Renewals / Surveys, etc.
 Corner originally set by Daniel Chaplin under contract No. 107, Dated September 21, 1864.
 His record reads: Set stone 15 x 8 x 6, for 1/4 sec. corner. J. Kimbrell in the Record of Private Surveys Book 2, Page 239 dated October 29, 1913, stated: set stone 18 x 9 x 6.

Monument and Accessories found: (condition and source)
 The centerline of the County Road and a fence running east that fit the Kimbrell record very well.

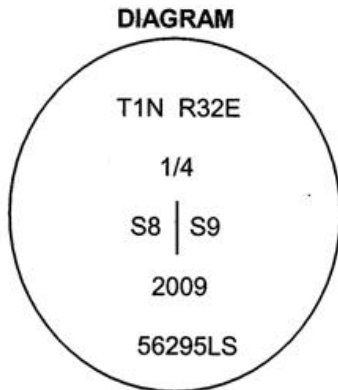

⊗ = Brass Cap
 ● = Rebar Reference

A hand-drawn sketch showing a road labeled "George Canyon Road" running vertically. To the right of the road is a "Power Pole" with an "Overhead Power Line" extending to the right. A fence line, indicated by 'x' marks, runs east-west across the road. A north arrow is shown to the left of the road.

MONUMENT (S) AND ACCESSORIES SET (Procedures and Description)
 Set a 1 1/2" x 30" galvanized iron pipe with a 2 1/2" brass cap stamped as shown in the diagram above at the intersection of the county road centerline with the fence running east.

For references, I set four 5/8" by 24" iron rebars with 1 1/4" orange plastic caps stamped WTS and 56295LS as described below:
 an iron rebar bears N31°23'11"W, 55.21 feet 20 inches below the surface of a field;
 an iron rebar bears N28°22'36"E, 54.62 feet on the south side of a power pole;
 an iron rebar bears S52°56'57"E, 55.20 feet 20 inches below the surface;
 an iron rebar bears S49°48'48"W, 35.29 feet in the existing fence;

This monument and references were tied using a Trimble R7/R8 RTK GPS system.

Location and comments
 NAD 83/1991 State Plane Coordinate
 Oregon North Zone
 N = 702,141.00 ift
 E = 8,630,183.61 ift

Compass Declination

Surveyors Seal

RECEIVED BY:
 Umatilla County Surveyor
 Date: 6-10
 Rec'd By: KK
 No. 10-93-C

Firm / Agency
 Witness Tree Surveying
 Address
 P.O. Box G
 Pilot Rock, Or. 97868
 Party Chief
 Stephen K, Haddock

REGISTERED
 PROFESSIONAL
 LAND SURVEYOR

Stephen K. Haddock

OREGON
 JULY 9, 2001
 STEPHEN K. HADDOCK
 56295LS

RENEWAL DATE 6-30-11