

**OREGON CORNER RESTORATION FORM**

Section 10 Township 1N Range 32E  
 County Umatilla Date: September 3, 2009

Corner Designation: 1N32J15

Condition Report Only

Not found

Remonumented

Unrecorded

Surveyed in


Referenced out

Quarter corner common to sections 10 and 15, T1N, R32E, W.M., Umatilla County, Oregon.

Previous Renewals / Surveys, etc.

Corner originally set by Daniel Chaplin under contract No. 107 dated September 21, 1864. His record reads: Set stone 16 x 10 x 8, for 1/4 sec. corner. J. Kimbrell in record of survey in Book 1, Page 422 stated: Set stone. In Partition Plat 2009-19, Bill Wells held a proportionate point but did not monument it.

Monument and Accessories found: ( condition and source )  
 None. The point falls in a farmed field.

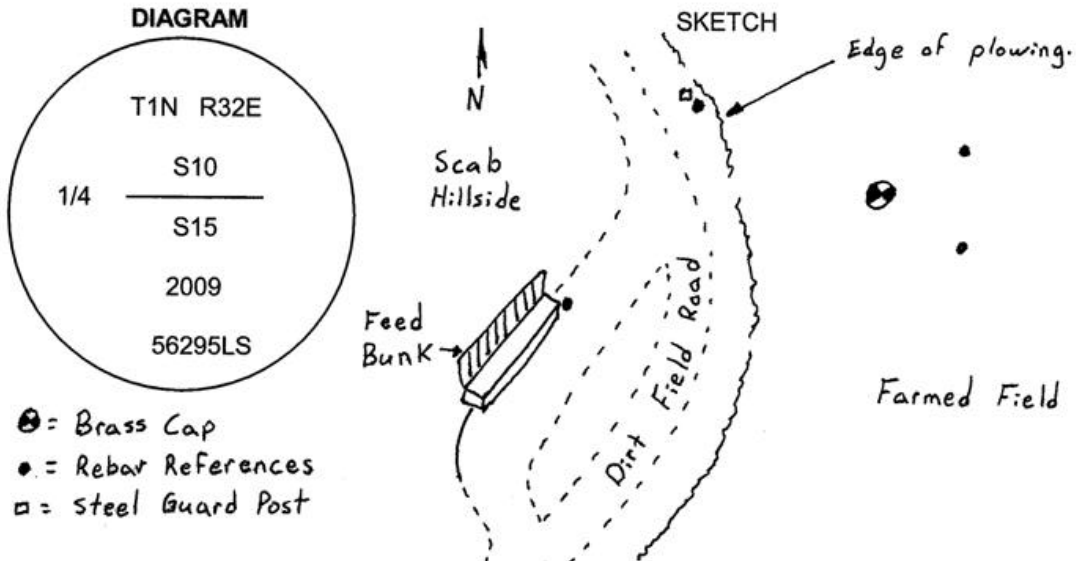

**MONUMENT (S) AND ACCESSORIES SET (Procedures and Description)**

I held the point from Partition Plat 2009-19. At the corner point I set a 1 1/2" x 30" galvanized iron pipe with a 2 1/2" brass cap stamped as shown in the diagram above. The cap is 24" below the surface of the plowed field.

For references, I set four 5/8" by 24" iron rebars with 1 1/4" orange plastic caps stamped WTS and 56295LS as described below:

- an iron rebar bears N69°38'32"W, 63.12 feet;
- an iron rebar bears N25°00'39"E, 37.95 feet, 2 feet below the surface of the field;
- an iron rebar bears S46°56'34"E, 42.10 feet, 2 feet below the surface of the field;
- an iron rebar bears S28°36'45"W, 123.50 feet at the corner of a concrete feed bunk;

The monument was set and references tied using a Trimble R7/R8 RTK GPS system.

Location and comments  
 NAD 83/1991 State Plane Coordinate  
 Oregon North Zone  
 N = 699,651.70 ift  
 E = 8,638,102.73 ift

Compass Declination

Surveyors Seal

RECEIVED BY:  
Umatilla County Surveyor  
 Date: 6-10  
 Rec'd By: KE  
 No. 10-950

Firm / Agency  
 Witness Tree Surveying  
 Address  
 P.O. Box G  
 Pilot Rock, Or. 97868  
 Party Chief  
 Stephen K, Haddock

REGISTERED  
 PROFESSIONAL  
 LAND SURVEYOR

*Stephen K. Haddock*

OREGON  
 JULY 9, 2001  
 STEPHEN K. HADDOCK  
 56295LS

RENEWAL DATE 6-30-11