

OREGON CORNER RE-MONUMENTATION FORM

Section 17 Township 1N Range 32E
 County Umatilla Date: March 6th, 2006


Corner Designation: 1N32J5

Condition Report Only
 Not found
 Remonumented
 Unrecorded
 Surveyed in
 Referenced out

Corner to sections 7, 8, 17 and 18, T1N, R32E W.M.

Previous Renewals / Surveys, etc.
 Corner originally set by Daniel Chaplin under contract No. 107 Dated September 21, 1864.
 His record reads: Set post for corner to sections 7, 8, 17, & 18 in mound of earth with charred stake, pits &c. as per instructions.

Monument and Accessories found: (condition and source)
 None. A long term fence with fences running North, South and West now marks this corner.

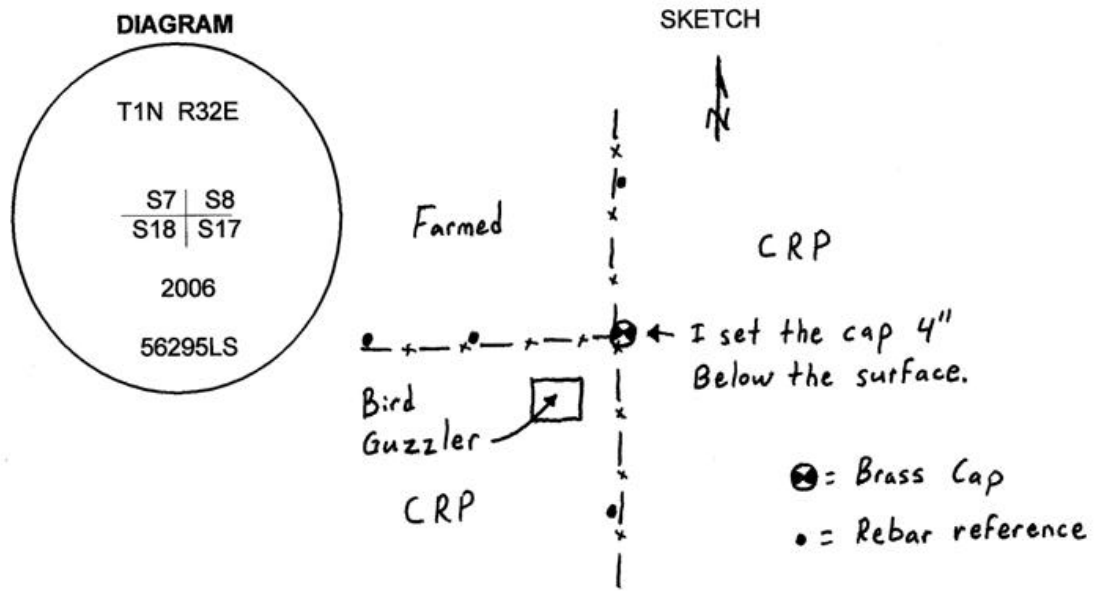

MONUMENT (S) AND ACCESSORIES SET (Procedures and Description)
 I set a 1 1/4" x 30" Galvanized Iron Pipe with a 2 1/2" brass cap stamped as shown in the diagram above at the fence corner.

For references I set four 5/8" x 24" iron rebars with 1.25" orange plastic caps stamped WTS and 56295LS as described below:
 an iron rebar bears N03°01'58"W, 56.32 feet under the existing fence;
 an iron rebar bears N88°33'08"W, 39.17 feet under the existing fence;
 an iron rebar bears N89°10'48"W, 83.74 feet under the existing fence;
 an iron rebar bears S01°07'42"E, 54.87 feet under the existing fence;

The monument and references were tied using a Trimble R7/R8 RTK GPS.

Location and comments

Compass Declination

Surveyors Seal

RECEIVED BY:
Umatilla County Surveyor
 Date: 5-06
 Rec'd By: [Signature]
 No. 06-140-B

Firm / Agency
 Witness Tree Surveying
 Address
 P.O. Box G
 Pilot Rock, OR 97868
 Party Chief
 Stephen K, Haddock

REGISTERED
 PROFESSIONAL
 LAND SURVEYOR
Stephen K. Haddock
 OREGON
 JULY 9, 2001
 STEPHEN K. HADDOCK
 56295LS
 RENEWAL DATE 6-30-07