

OREGON CORNER RESTORATION FORM

Section 17 Township 1N Range 32E
County Umatilla Date: July 29, 2009

Corner Designation: 1N32J5 Condition Report Only
Not found
Remonumented
Unrecorded
Surveyed in
Referenced out

Corner common to sections 7, 8, 17 and 18, T1N, R32E, W.M., Umatilla County, Oregon.


Previous Renewals / Surveys, etc.

Corner originally set by Daniel Chaplin under contract No. 107 Dated September 21, 1864. His record reads: Set post for corner to sections 7, 8, 17, & 18 in mound of earth with charred stake, pits &c. as per instructions. Stephen K. Haddock under survey 06-140-B states: Set brass cap and four reference monuments.

Monument and Accessories found: (condition and source)
I found my brass cap and references in good condition as described.

DIAGRAM

SKETCH

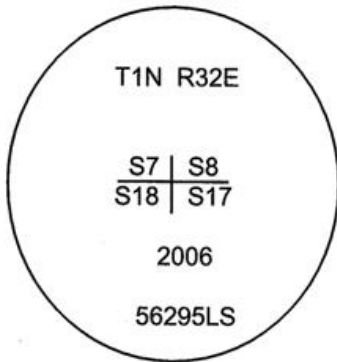

MONUMENT (S) AND ACCESSORIES SET (Procedures and Description)
I held my previous monument.

For references:

The monument was tied using a Trimble R7/R8 RTK GPS system.

Location and comments
NAD 83/1991 State Plane Coordinate
Oregon North Zone
N = 699,405.21 ift
E = 8,624,913.32 ift

Compass Declination

Surveyors Seal

RECEIVED BY:
Umatilla County Surveyor
Date: 6-10
Rec'd By: KE
No. 10-93-c

Firm / Agency
Witness Tree Surveying
Address
P.O. Box G
Pilot Rock, OR 97868
Party Chief
Stephen K, Haddock

REGISTERED
PROFESSIONAL
LAND SURVEYOR

Stephen K. Haddock

OREGON
JULY 9, 2001
STEPHEN K. HADDOCK
56295LS

RENEWAL DATE 6-30-11