

OREGON CORNER RESTORATION FORM

Section 16 Township 1N Range 32E
 County Umatilla Date: December 19, 2009

Corner Designation: 1N32N11


Quarter corner common to sections 16 and 21,
 T1N, R32E, W.M., Umatilla County, Oregon.

Previous Renewals / Surveys, etc.

Corner originally set by Daniel Chaplin under contract No. 107 dated September 21, 1864.
 His record reads: Set post for 1/4 sec. cor. in mound of earth with charred stake, pits &c as per instructions.

Condition Report Only
 Not found
 Remonumented
 Unrecorded
 Surveyed in
 Referenced out

Monument and Accessories found: (condition and source)
 A fence line running south and northeast and a plow berm running east.

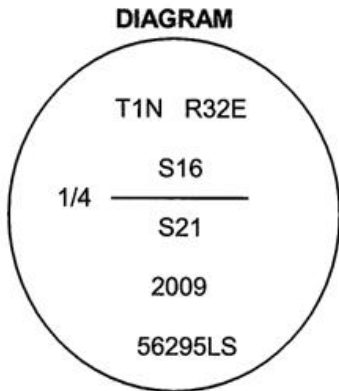

MONUMENT (S) AND ACCESSORIES SET (Procedures and Description)

At the intersection of the fence to the south and the plow line east I set a 1 1/2"x30" galvanized iron pipe with a 2 1/2" brass cap stamped as shown in the diagram above.

For references, I set four 5/8" by 24" iron rebars with 1 1/4" orange plastic caps stamped WTS and 56295LS as described below:

- an iron rebar bears N89°51'02"W, 63.96 feet 2 feet below the surface;
- an iron rebar bears N31°46'13"E, 57.53 feet under the existing fence;
- an iron rebar bears N89°44'58"E, 94.34 feet 2 feet under the surface;
- an iron rebar bears S01°54'44"E, 96.33 feet under the existing fence;

The monument and references were tied using a Trimble R7/R8 RTK GPS system.

Location and comments
 NAD 83/1991 State Plane Coordinate
 Oregon North Zone
 N = 694,269.31 ift
 E = 8,632,938.65 ift

Compass Declination

Surveyors Seal

RECEIVED BY:
Umatilla County Surveyor
 Date: 6-10
 Rec'd By: SK
 No. 10-93-C

Firm / Agency
 Witness Tree Surveying
 Address
 P.O. Box G
 Pilot Rock, Or. 97868
 Party Chief
 Stephen K, Haddock

REGISTERED
 PROFESSIONAL
 LAND SURVEYOR

Stephen K. Haddock

OREGON
 JULY 9, 2001
 STEPHEN K. HADDOCK
 56295LS

RENEWAL DATE 6-30-11