

OREGON CORNER RESTORATION FORM

Section 15 Township 1N Range 32E
County Umatilla Date: July 29, 2009

Corner Designation: 1N32N17

Corner common to sections 14, 15, 22, and 23,
T1N, R32E, W.M., Umatilla County, Oregon.


Previous Renewals / Surveys, etc.

Corner was originally set by Daniel Chaplin under contract No. 107 dated September 21, 1864. His record reads: Set post for corner to secs. 14, 15, 22 and 23 in mound of earth with charred stake, pits &c as per instructions. Survey H-253-B states: Computed position. William R. Wells in survey 06-528-C states: Set aluminum cap and four references.

Monument and Accessories found: (condition and source)
The aluminum cap set by Wells is in good condition.

Condition Report Only
 Not found
 Remonumented
 Unrecorded
 Surveyed in
 Referenced out

DIAGRAM

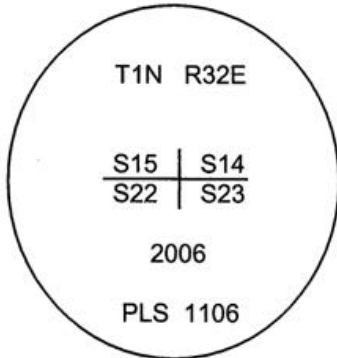

SKETCH

MONUMENT (S) AND ACCESSORIES SET (Procedures and Description)

None. I held the monument by Wells. This certificate is being prepared to report the state plane coordinates for the corner point as shown below.

For references:

The monument was tied using a Trimble R7/R8 RTK GPS system.

Location and comments
NAD 83/1991 State Plane Coordinate
Oregon North Zone
N = 694,406.50 ft
E = 8,640,868.53 ft

Compass Declination

Surveyors Seal

RECEIVED BY:
Umatilla County Surveyor
Date: 6-10
Rec'd By: PK
No. 10-93-C

Firm / Agency
Witness Tree Surveying
Address
P.O. Box G
Pilot Rock, Or. 97868
Party Chief
Stephen K, Haddock

REGISTERED
PROFESSIONAL
LAND SURVEYOR

Stephen K. Haddock

OREGON
JULY 9, 2001
STEPHEN K. HADDOCK
56295LS

RENEWAL DATE 6-30-11