

**OREGON CORNER RESTORATION FORM**

Section 21 Township 1N Range 32E  
County Umatilla Date: July 9, 2009

Corner Designation: 1N32R13

Condition Report Only  
 Not found  
 Remonumented  
 Unrecorded  
 Surveyed in  
 Referenced out

Corner common to sections 21, 22, 27, and 28,  
T1N, R32E, W.M., Umatilla County, Oregon.


Previous Renewals / Surveys, etc.

Corner was originally set by Daniel Chaplin under contract No. 107 dated September 21, 1864. His record reads: Set post for corner to secs. 21, 22, 27 and 28 in mound of earth with charred stake, pits &c as per instructions. J. Kimbrell in record of survey in Book 1, Page 489 states: Set stone 20 x 10 x 8. Aubrey Perry, in the Record of Private Surveys, Book 2, Page 317 states: found point where old charred cottonwood stake was in center of road. William R. Wells, under survey 06-528-C states: Set aluminum cap and four references.

Monument and Accessories found: ( condition and source )  
I found the monument by Wells in good condition.

**DIAGRAM**

**SKETCH**

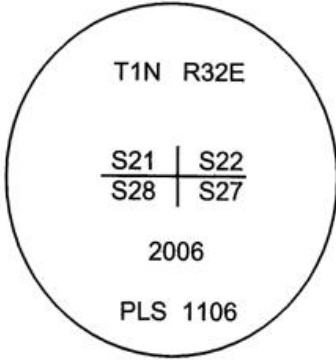

**MONUMENT (S) AND ACCESSORIES SET (Procedures and Description)**

None. I held the monument by Wells. This certificate is being recorded to report the state plane coordinates shown below.

For references:

The monument was tied using a Trimble R7/R8 RTK GPS system.

Location and comments  
NAD 83/1991 State Plane Coordinate  
Oregon North Zone  
N = 689,036.96 ft  
E = 8,635,667.15 ft

Compass Declination

Surveyors Seal

RECEIVED BY:  
Umatilla County Surveyor  
Date: 6-10  
Rec'd By: KK  
No. 10-95-C

Firm / Agency  
Witness Tree Surveying  
Address  
P.O. Box G  
Pilot Rock, Or. 97868  
Party Chief  
Stephen K, Haddock

REGISTERED  
PROFESSIONAL  
LAND SURVEYOR

*Stephen K. Haddock*

OREGON  
JULY 9, 2001  
STEPHEN K. HADDOCK  
58295LS

RENEWAL DATE: 6-30-11