

**OREGON CORNER RESTORATION FORM**

Section 23 Township 1N Range 32E  
 County Umatilla Date: July 29, 2009

Corner Designation: 1N32R19

Quarter corner common to sections 23 and 26,  
 T1N, R32E, W.M., Umatilla County, Oregon.


Previous Renewals / Surveys, etc.

Corner originally set by Daniel Chaplin under contract #107 dated September 21, 1864. His record reads: Set post for 1/4 sec. corner in mound of earth with charred stake, pits, &c. as per instructions. The corner was re-established by Currin and Noland under special instructions dated May 4th 1887. Their record reads: Set a stone, 6x8x10ins., 7 ins. in the ground for the 1/4 sec. cor. marked 1/4 on N. face, dug pits, 18x18x12 ins., E. and W. 5 1/2 ft. dist. from stone and raised a mound of earth 1 1/2 ft. high, 3 1/2 ft. base over it. ODOT Highway Right of Way map No. 8B-15-12 dated August, 1959 says Stone fd. In survey 02-161-B, I set a 1"x24" iron rebar with a 2" aluminum cap stamped as shown in the diagram below.

Condition Report Only  
 Not found  
 Remonumented  
 Unrecorded  
 Surveyed in  
 Referenced out

Monument and Accessories found: ( condition and source )  
 I found my monument from 02-161-B in good condition as described.

**DIAGRAM**

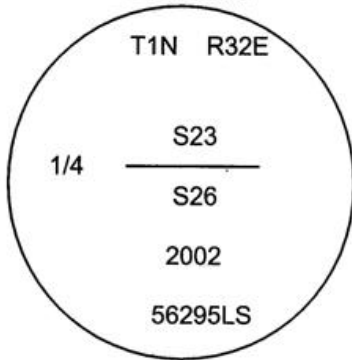

**SKETCH**

**MONUMENT (S) AND ACCESSORIES SET (Procedures and Description)**

None. I held my previous monument. This certificate is being recorded to report the state plane coordinates shown below.

For references:

The monument was tied using a Trimble R7/R8 RTK GPS system.

Location and comments  
 NAD 83/1991 State Plane Coordinate  
 Oregon North Zone  
 N = 689,157.95 ift  
 E = 8,643,581.35 ift

Compass Declination

Surveyors Seal

RECEIVED BY:  
Umatilla County Surveyor  
 Date: 6-10  
 Rec'd By: KK  
 No. 10-93-c

Firm / Agency  
 Witness Tree Surveying  
 Address  
 P.O. Box G  
 Pilot Rock, Or. 97868  
 Party Chief  
 Stephen K, Haddock

REGISTERED  
 PROFESSIONAL  
 LAND SURVEYOR

*Stephen K. Haddock*

OREGON  
 JULY 9, 2001  
 STEPHEN K. HADDOCK  
 56295LS

RENEWAL DATE 6-30-11