

**OREGON CORNER RESTORATION FORM**

Section 30 Township 1N Range 32E  
 County Umatilla Date: September 15, 2009

Corner Designation: 1N32T5


Quarter corner common to sections 29 and 30,  
 T1N, R32E, W.M., Umatilla County, Oregon.

Condition Report Only  
 Not found  
 Remonumented  
 Unrecorded  
 Surveyed in  
 Referenced out

Previous Renewals / Surveys, etc.

Corner originally set by Daniel Chaplin under contract No. 107 Dated September 21, 1864.  
 His record reads: Set post for 1/4 section corner in mound of earth with charred stake,  
 pits, etc., as per instructions.

Monument and Accessories found: ( condition and source )  
 None. The point falls in the middle of the county road.

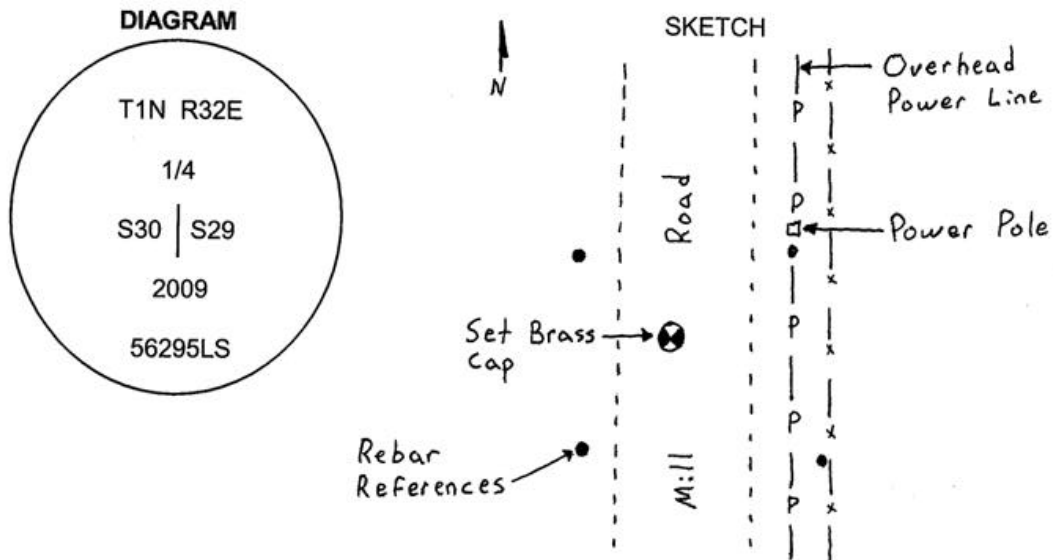

**MONUMENT (S) AND ACCESSORIES SET (Procedures and Description)**

I set a 1 1/2" x 30" galvanized iron pipe with a 2 1/2" brass cap stamped as shown in the diagram above by proportioning the latitude and holding the center of the county road as determined by the right of way fence.

For references, I set four 5/8" by 24" iron rebars with 1 1/4" orange plastic caps stamped WTS and 56295LS as described below:

- an iron rebar bears N42°09'51"W, 23.62 feet, 2 feet below the surface of a farmed field;
- an iron rebar bears N42°13'10"E, 42.00 feet on the south side of a power pole;
- an iron rebar bears S52°15'44"E, 36.04 feet in the existing fence;
- an iron rebar bears S40°21'23"W, 22.77 feet, 2 feet below the surface of a plowed field;

The monument was set and references tied using a Trimble R7/R8 RTK GPS system.

Location and comments  
 NAD 83/1991 State Plane Coordinate  
 Oregon North Zone  
 N = 686,175.87 ft  
 E = 8,625,184.48 ft

Compass Declination  
 Firm / Agency  
 Witness Tree Surveying  
 Address  
 P.O. Box G  
 Pilot Rock, OR 97868  
 Party Chief  
 Stephen K, Haddock

Surveyors Seal

REGISTERED  
 PROFESSIONAL  
 LAND SURVEYOR

*Stephen K. Haddock*

OREGON  
 JULY 9, 2001  
 STEPHEN K. HADDOCK  
 56295LS

RENEWAL DATE 6-30-11

RECEIVED BY:  
 Umatilla County Surveyor  
 Date: 6-10  
 Rec'd By: KK  
 No. 10-93-C