

OREGON CORNER RESTORATION FORM

Section 29 Township 1N Range 32E
 County Umatilla Date: September 15, 2009

Corner Designation: 1N32T9

Quarter corner common to sections 29 and 28,
 T1N, R32E, W.M., Umatilla County, Oregon.



Condition Report Only
 Not found

Remonumented
 Unrecorded
 Surveyed in
 Referenced out

Previous Renewals / Surveys, etc.

Corner originally set by Daniel Chaplin under contract No. 107 Dated September 21, 1864.
 His record reads: Set stone, 16 x 10 x 10, for 1/4 sec. corner.

Monument and Accessories found: (condition and source)
 None. The point falls in a wheat field.

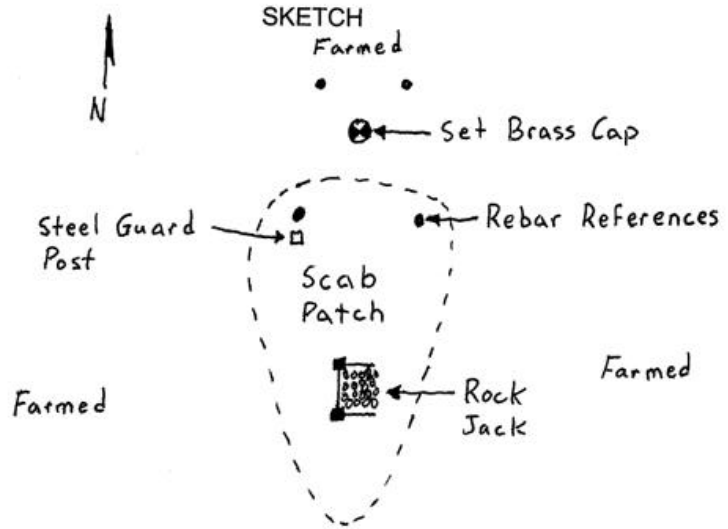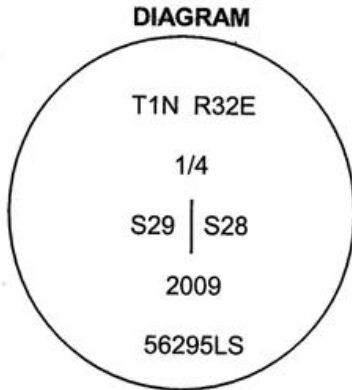

MONUMENT (S) AND ACCESSORIES SET (Procedures and Description)

I set a 1 1/2" x 30" galvanized iron pipe with a 2 1/2" brass cap stamped as shown in the diagram above at the proportionate point. I sawed the pipe and bent it in half and set it on bedrock. The cap is 24" below the surface of the field.

For references, I set four 5/8" by 24" iron rebars with 1 1/4" orange plastic caps stamped WTS and 56295LS as described below:

- an iron rebar bears N45°28'58"W, 35.09 feet, 2 feet below the surface of the field;
- an iron rebar bears N39°43'15"E, 32.01 feet, 2 feet below the surface of the field;
- an iron rebar bears S29°43'35"E, 72.66 feet in a scab patch;
- an iron rebar bears S41°36'01"W, 36.01 feet in a scab patch;

The monument was set references tied using a Trimble R7/R8 RTK GPS system.

Location and comments
 NAD 83/1991 State Plane Coordinate
 Oregon North Zone
 N = 686,269.78 ft
 E = 8,630,452.08 ft

Compass Declination

Firm / Agency
 Witness Tree Surveying
 Address
 P.O. Box G
 Pilot Rock, OR 97868
 Party Chief
 Stephen K, Haddock

Surveyors Seal

REGISTERED
 PROFESSIONAL
 LAND SURVEYOR

Stephen K. Haddock

OREGON
 JULY 9, 2001
 STEPHEN K. HADDOCK
 56295LS

RENEWAL DATE 6-30-11

RECEIVED BY:
Umatilla County Surveyor
 Date: 6-10
 Rec'd By: KK
 No. 10-93-C