

**OREGON CORNER RESTORATION FORM**

Section 25 Township 1N Range 32E  
 County Umatilla Date: June 29, 2009

Corner Designation: 1N32V25

Condition Report Only  
 Not found  
 Remonumented  
 Unrecorded  
 Surveyed in  
 Referenced out

Corner to sections 25 and 36 only, T1N, R32E, W.M., Umatilla County, Oregon.


Previous Renewals / Surveys, etc.

Corner originally set by David P. Thompson under contract No. 106 dated August 16, 1864. His record reads: Set post cor. for secs. 30, 31, 25, and 36 in mound of earth with charred stake pits and trench as per instructions. Zenas Moody, under contract No. 164 dated October 4, 1871 says: Set post and made earth mound for cor. to secs. 25, 30, 36 and 31. James Currin and James Noland under special contract dated May 4, 1887 state: Found old mound and pits. Set a basalt stone, 16x12x8 ins. mkd. 1 notches on S. and 5 on N. edges. Lincoln Wilkes in the survey of the diminished Indian Reservation states: Set an iron post 3 ft. long, 2 ins. diam. with brass cap. David Krumbein, in survey 04-182-B says: Found fence line East and South and plow line East. Set Brass Cap.


Monument and accessories found. (condition and source)

I found the brass cap by Wilkes in good condition. I also found the brass cap by Krumbein at the fence corner 4.6' southerly. The Krumbein cap is unmarked and no references had been set.

**DIAGRAM**

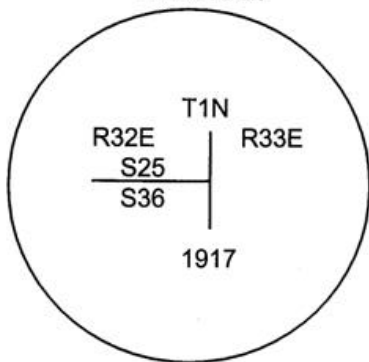

**SKETCH**

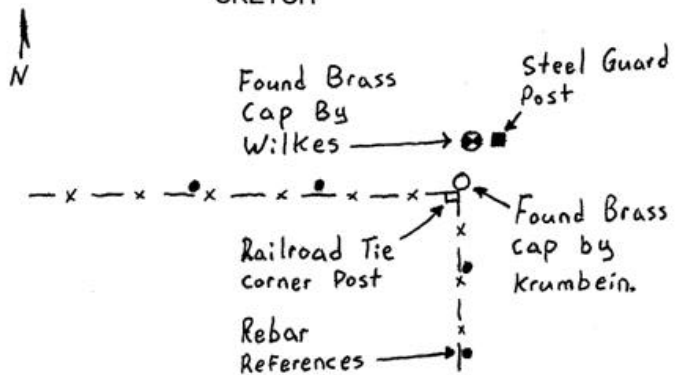

MONUMENT (S) AND ACCESSORIES SET (Procedures and Description)

I left the Wilkes monument in place undisturbed. I set a 6' steel guard post on the east side of the Wilkes monument.

For references I set four 5/8" x 24" iron rebars with 1 1/4" orange plastic caps stamped WTS and 56295LS as follows:

- an iron rebar bears S01°04'21"W 48.18 feet under the existing fence;
- an iron rebar bears S00°31'54"W 129.12 feet under the existing fence;
- an iron rebar bears S87°42'40"W 60.55 feet under the existing fence;
- an iron rebar bears N89°47'59"W 133.04 feet under the existing fence;
- the brass cap by Krumbein bears S15°59'13"W 4.59 feet at the corner of the existing fence.

The monument and references were tied using a Trimble R7/R8 RTK GPS system.

Location and comments  
 NAD 83/1991 State Plane Coordinate  
 Oregon North Zone  
 N = 684,035.31 ift  
 E = 8,651,615.46 ift

Compass Declination

Surveyors Seal

RECEIVED BY:  
Umatilla County Surveyor  
 Date: 6-10  
 Rec'd By: KK  
 No. 10-93-0

Firm / Agency  
 Witness Tree Surveying  
 Address  
 P.O. Box G  
 Pilot Rock, Or. 97868  
 Party Chief  
 Stephen K, Haddock

REGISTERED  
 PROFESSIONAL  
 LAND SURVEYOR

*Stephen K. Haddock*

OREGON  
 JULY 9, 2001  
 STEPHEN K. HADDOCK  
 56295LS

RENEWAL DATE 6-30-11