

OREGON CORNER RESTORATION FORM

Section 33 Township 1N Range 32E
County Umatilla Date: September 10, 2009

Corner Designation: 1N32X13 Condition Report Only
Not found
Remonumented
Unrecorded
Surveyed in
Referenced out

Quarter corner common to sections 33 and 34,
T1N, R32E, W.M., Umatilla County, Oregon.


Previous Renewals / Surveys, etc.

Corner originally set by Daniel Chaplin under contract No. 107 Dated September 21, 1864.
His record reads: Set post for 1/4 section corner in mound of earth with charred stake,
pits, etc., as per instructions. Aubrey Perry in record of survey in Book 2, Page 317 stated: Set
rock 16" x 8" x 10", dated September 5-6, 1921. David L. Haddock in record of survey 97-145-C
states: Set brass cap and four reference monuments.

Monument and Accessories found: (condition and source)
I found the brass cap by Haddock in good condition.

DIAGRAM

SKETCH

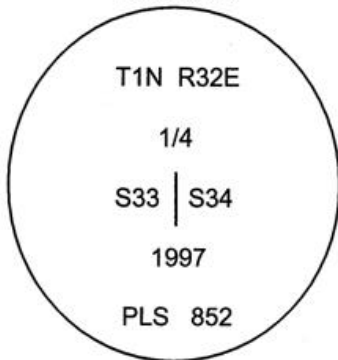

MONUMENT (S) AND ACCESSORIES SET (Procedures and Description)

None. I held the brass cap from 97-145-C. This certificate is being filed to report the state
plane coordinates shown below.

For references:

The monument was tied using a Trimble R7/R8 RTK GPS system.

Location and comments
NAD 83/1991 State Plane Coordinate
Oregon North Zone
N = 681,137.61 ift
E = 8,635,839.87 ift

Compass Declination

Surveyors Seal

RECEIVED BY:
Umatilla County Surveyor
Date: 6-10
Rec'd By: KK
No. 10-93-C

Firm / Agency
Witness Tree Surveying
Address
P.O. Box G
Pilot Rock, OR 97868
Party Chief
Stephen K, Haddock

REGISTERED
PROFESSIONAL
LAND SURVEYOR

Stephen K. Haddock

OREGON
JULY 9, 2001
STEPHEN K. HADDOCK
56295LS

RENEWAL DATE 6-30-11