

CERTIFIED RECORD OF LAND CORNER MONUMENTATION

Corner to Sections 33 and 34 , T1N, R32E, W M.

Index: 1N 32 Z-13


DIAGRAM

History of original corner establishment:

Corner originally set by Thompson in contract 79 dated 1858. His record reads: 80.00 Set post for corner to secs. 33 and 34 and build a mound of earth as per instructions.

An error was discovered in the chaining along the baseline. Thompson in contract 106, in 1864, established a new corner. His record reads: 80.00 Set post for corner to secs. 33 and 34 in mound of earth with charred stake, pits, trench &c as per instructions.

Record of Private Surveys, Book 2 records on page 299 that Umatilla County Surveyor, Aubrey Perry remonumented this corner in 1919. His record reads: Found point of old cottonwood stake set by Gov. surveyors. Moved Kimbrell's rock, 6x6x14, 15 lks. north and reset it at this point.

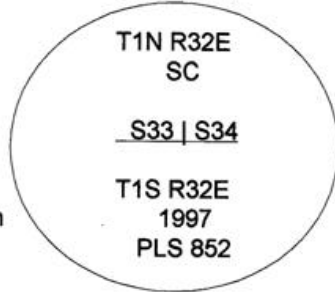

Evidence Found: Found Perry's stone as recorded under an east - west fence 2.1 feet below the surface of the ground.

Description of monument and accessories I established to perpetuate the location of this corner:

Left the stone in position and set a 1.25" x 30" galvanized iron pipe, with 2.25" brass cap stamped as shown in the diagram, on top of the stone.

I set four 5/8" by 24" rebars with 1.25" red plastic caps stamped ORLS 852 and WALS 13922 as described below:

- a rebar bears N89°27'W, 93.74 feet under a west bound fence;
- a rebar bears N89°27'W, 43.96 feet under an west bound fence;
- a rebar bears S89°42'E, 52.63 feet under an east bound fence;
- a rebar bears S89°35'E, 152.17 feet at the intersection of east bound and south bound fences;

The bearings are true.

This work was done June 16, 1997, and witnessed by Stephen K. Haddock.

County of Umatilla
I hereby certify that the within instrument was filed

Office of _____ by _____
State of _____ (COUNTY OFFICIAL) (DEPUTY)
in this office for record on the _____ day of _____, 19____.

REGISTERED PROFESSIONAL LAND SURVEYOR

David L. Haddock

OREGON JULY 12, 1906 DAVID L. HADDOCK 852

RECEIVED BY

Umatilla County Surveyor

Date: 7-97

Rec'd By: KK

No. 97-140-C