

CERTIFIED RECORD OF LAND CORNER MONUMENTATION

Corner to Sections 31 and 32, T1N, R32E, W M.


Index: 1N 32 Z-5

DIAGRAM

History of original corner establishment:

Corner originally set by Thompson in contract 79 dated 1858. His record reads: 80.00 Set stone, 10x10x8 ins., for corner to secs. 31 and 32 and build mound of earth as per instructions.

An error was discovered in the chaining along the baseline. Thompson in contract 106, in 1864, established a new corner. His record reads: 80.00 Set post for corner to secs. 31 and 32 in mound of earth with charred stake, pits, trench &c as per instructions.

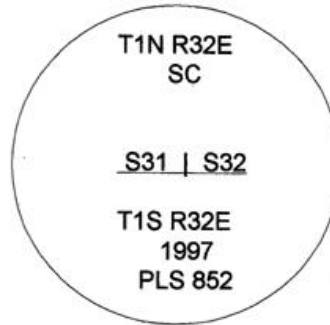

Evidence Found: None

Description of monument and accessories I established to perpetuate the location of this corner:

At the proportionate point between the corner of R31E and 32E, T1N and the found stone, set by survey recorded in book 2, page 299, for the corner to Sections 32 and 33, T1N, R32E.

I set a 1.25" x 12" galvanized iron pipe with 2.25" brass cap stamped as shown in the diagram and 20" below the surface of the ground at the edge of a wheat field just south of the point where the Mill Road turns to go north. The monument was cemented in a hole chiseled into rock.

I set four 5/8" by 24" rebars with 1.25" red plastic caps stamped ORLS 852 and WALS 13922 as described below:

- a rebar bears N32°48'W, 94.27 feet under the west north bound Mill Road right of way fence;
- a rebar bears N56°41'W, 62.08 feet under the west north bound Mill Road right of way fence;
- a rebar bears N18°47'E, 20.75 feet at the foot of a power pole;
- a rebar bears N84°52'E, 120.08 feet at the foot of the "2 mile" mile post paddle;


The bearings are true.

This work was done June 17, 1997, and witnessed by Stephen K. Haddock.

Office of _____, I hereby certify that the within instrument was filed
 State of _____ County of Umatilla
 in this office for record on the _____ day of _____ by _____
 _____ (COUNTY OFFICIAL) _____ (DEPUTY)



David L. Haddock

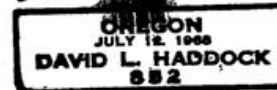

RECEIVED BY
 Umatilla County Surveyor
 Date 7-97
 Rec'd By BK
 No. 97-140-c