

CERTIFIED RECORD OF LAND CORNER MONUMENTATION

South quarter corner to Section 32 , T1N, R32E, W M.


Index: 1N 32 Z-7

History of original corner establishment:
Corner originally set by Thompson in contract 79 dated 1858. His record reads: 40.00 Set post for 1/4 sec. corner and build a mound of earth as per instructions.

An error was discovered in the chaining along the baseline.

Thompson in contract 106, in 1864, established a new corner. His record reads: 40.00 Set stone 18x12x4 ins., for 1/4 sec. corner.

DIAGRAM

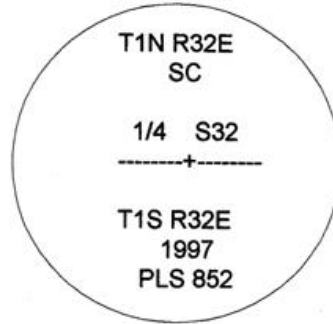

Evidence Found: None

Description of monument and accessories I established to perpetuate the location of this corner:

At the proportionate point between the corner of R31E and R32E, T1N and the found stone, set by survey recorded in Record of Surveys, book 2, page 299, for the corner to Sections 32 and 33, T1N, R32E.

I set a 1.25" x 30" galvanized iron pipe with 2.25" brass cap stamped as shown in the diagram and 12" above the surface of the ground. I placed a mound of stone around the monument. The monument is approximately 6' south of an existing fence.

I set four 5/8" by 24" rebars with 1.25" red plastic caps stamped ORLS 852 and WALS 13922 as described below:

- a rebar bears N85°28'W, 65.90 feet under a west bound fence;
- a rebar bears N83°18'E, 43.14 feet under an east bound fence;
- a rebar bears N86°49'E, 92.88 feet under an east bound fence;
- a rebar bears N71°33'W, 16.62 feet under a west bound fence;


The bearings are true.

This work was done June 16, 1997, and witnessed by Stephen K. Haddock.

Office of _____, I hereby certify that the within instrument was filed
 State of _____ County of Umatilla
 in this office for record on the _____ day of _____ by _____
 _____ (COUNTY OFFICIAL) _____ (DEPUTY)



David L. Haddock

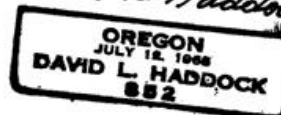

RECEIVED BY

Umatilla County Surveyor

Date: 7-97

Rec'd By: KK

No. 97-140-C