

OREGON CORNER RESTORATION FORM

Section 6 Township 1N Range 33E
County Umatilla Date: July 2, 2009

Corner Designation: 1N33C1

Condition Report Only
 Not found
 Remonumented
 Unrecorded
 Surveyed in
 Referenced out

West quarter corner to section 6 only , T1N, R33E, W.M.,
Umatilla County, Oregon


Previous Renewals / Surveys, etc.

The corner was originally set by James Currin and James Noland under Special Instructions dated May 4, 1887. Their record states: Set stone 12x10x10 marked 1/4 CC on E. Face and raised a mound of earth over it. Lincoln Wilkes in the 1917 survey of the Diminished Indian Reservation states: Found old stake 20x4x1 1/2 ins. marked R and illegible marks on E. face. Set an iron post 3 ft. long, 2 ins. diam. for witness corner to 1/4 cor. of sec. 6 with brass cap. Brian Siebold in his 2000 dependent resurvey states: Set a mag nail, 2 1/2 ins. long, flush with the asphalt. A stainless steel post, 28 ins. long 2 1/2" diam. with brass cap was set for a reference monument.

Monument and Accessories found: (condition and source)

I found the mag nail and witness cap set by Siebold in good condition as described.

DIAGRAM

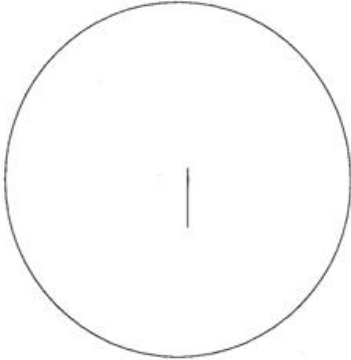

SKETCH

MONUMENT (S) AND ACCESSORIES SET (Procedures and Description)

None. This certificate is being filed to report the State Plane Coordinates only.

For references:

The monument and witness cap were tied using a Trimble R7/R8 RTK GPS system.

Location and comments
NAD 83/1991 State Plane Coordinate
Oregon North Zone
N=708,001.59 ft
E=8,651,169.35 ft

Compass Declination

Surveyors Seal

RECEIVED BY:
Umatilla County Surveyor
Date: 6-10
Rec'd By: KK
No. 10-93-C

Witness Tree Surveying
Address
P.O. Box G
Pilot Rock, Or. 97868
Party Chief
Stephen K, Haddock

REGISTERED
PROFESSIONAL
LAND SURVEYOR

Stephen K. Haddock

OREGON
JULY 9, 2001
STEPHEN K. HADDOCK
56295LS

RENEWAL DATE 6-30-11