

**OREGON CORNER RESTORATION FORM**

Section 7 Township 1N Range 33E  
 County Umatilla Date: July 7, 2009

Corner Designation: 1N33J1

Closing corner to sections 7 and 18, T1N, R33E, W.M.,  
 Umatilla County, Oregon.


Condition Report Only  
 Not found  
 Remonumented  
 Unrecorded  
 Surveyed in  
 Referenced out

Previous Renewals / Surveys, etc.

Corner originally set by James Currin and James Noland under special instructions dated May 4, 1887. Their record reads: Set basalt stone 16x10x8 ins. marked CC on E. with 4 notches on S. and 2 notches N. faces. Dug pits and raised mound of earth over it. Lincoln Wilkes in his 1917 survey of the Diminished Indian Reservation states: Found basalt stone 14x9x5 marked CC on E. face. Set an iron post 3 ft. long, 2 ins. diam. for witness cor. to the closing cor. of secs. 6 and 7, in the center of a lane extending E. and S.

Monument and accessories found. (condition and source)

I found a basalt stone 15x8x6 ins. marked CC on the E. face and 3 notches on the north. There was a 6"x1/2"x15" plow shear driven along the north side.

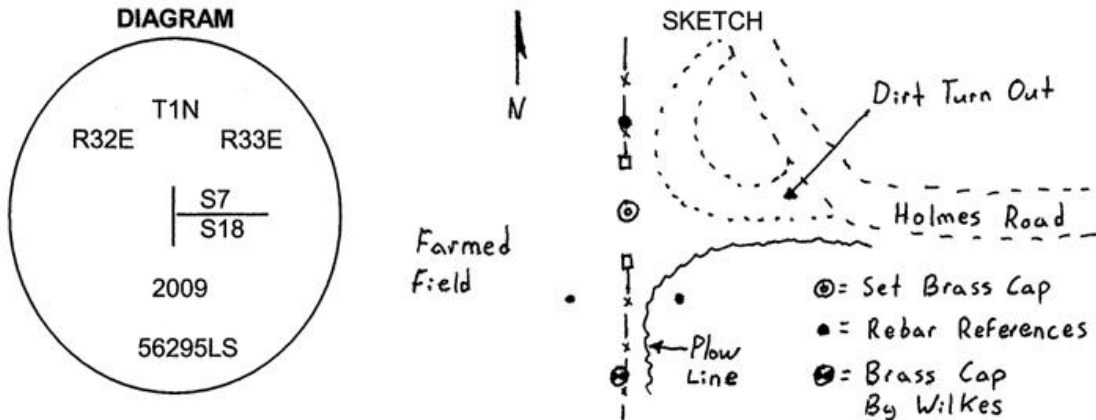

**MONUMENT (S) AND ACCESSORIES SET (Procedures and Description)**

At the corner point I set a 1 1/2" x 30" galvanized iron pipe with a 2 1/2" brass cap stamped as shown in the diagram above. The cap is 24" below the surface because it falls in the gate to a farmed field.

For references, I set three, 5/8" by 24" iron rebars with 1 1/4" orange plastic caps stamped WTS and 56295LS as described below:

- an iron rebar bears N01°17'21"W, 33.89 feet under the existing fence;
- an iron rebar bears S27°22'36"W, 72.78 feet 20 inches below the surface of a field;
- an iron rebar bears S27°06'54"E, 74.45 feet 20 inches below the surface of a field;

The brass capped monument by Wilkes marking the corner to Sections 1 and 12, T1N, R32E, bears S00°22'32"W 142.45 feet under the existing fence.

The monument and references were tied using a Trimble R7/R8 RTK GPS system.

Location and comments  
 NAD 83/1991 State Plane Coordinate  
 Oregon North Zone  
 N = 700,012.31 ift  
 E = 8,651,288.46 ift

Compass Declination

Surveyors Seal

RECEIVED BY:  
 Umatilla County Surveyor  
 Date: 6-10  
 Rec'd By: KL  
 No. 10-93-C

Firm / Agency  
 Witness Tree Surveying  
 Address  
 P.O. Box G  
 Pilot Rock, Or. 97868  
 Party Chief  
 Stephen K, Haddock

REGISTERED  
 PROFESSIONAL  
 LAND SURVEYOR

*Stephen K. Haddock*

OREGON  
 JULY 9, 2001  
 STEPHEN K. HADDOCK  
 56295LS

RENEWAL DATE 6-30-11