

OREGON CORNER RESTORATION FORM

Section 30 Township 1N Range 33E
 County Umatilla Date: July 13, 2009

Corner Designation: 1N33T1



Condition Report Only
 Not found
 Remonumented
 Unrecorded
 Surveyed in
 Referenced out

West quarter corner to section 30 only , T1N, R33E, W.M.,
 Umatilla County, Oregon

Previous Renewals / Surveys, etc.

The corner was originally set by James Currin and James Noland under Special Instructions dated May 4, 1887. Their record states: Set a basalt stone 10x8x6 marked 1/4 on W. Face and Dr on E. face. Dug pits and raised a mound of earth over it. Lincoln Wilkes in the 1917 survey of the Diminished Indian Reservation states: Set and iron post 3 ft. long, 2 ins. diam. for 1/4 cor. of sec. 30 only with brass cap.

Monument and Accessories found: (condition and source)
 I found the brass cap by Wilkes in good condition.

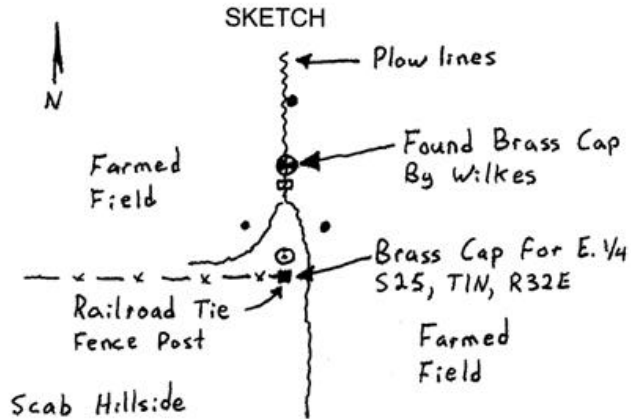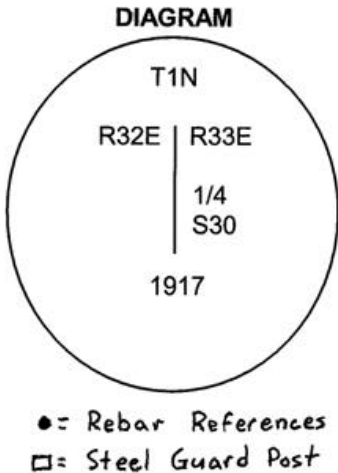

MONUMENT (S) AND ACCESSORIES SET (Procedures and Description)

I left the monument by Wilkes in place and undisturbed. I set a steel guard post on the south side of the cap.

For references I set three 5/8" x 24" iron rebars with 1 1/4" orange plastic caps stamped WTS and 56295LS as described below:

- an iron rebar bears N00°37'01"W 36.36 feet 2 feet below the surface;
- an iron rebar bears S38°59'06"E 47.53 feet 2 feet below the surface;
- an iron rebar bears S44°53'31"W 50.35 feet 2 feet below the surface;
- the brass cap monumenting the east quarter corner of Section 25, T1N, R32E bears S00°00'51"W 76.32 feet;

The monument and references were tied using a Trimble R7/R8 RTK GPS system.

Location and comments
 NAD 83/1991 State Plane Coordinate
 Oregon North Zone
 N=686,754.77 ft
 E=8,651,559.96 ft

Compass Declination
 Firm / Agency
 Witness Tree Surveying
 Address
 P.O. Box G
 Pilot Rock, Or. 97868
 Party Chief
 Stephen K, Haddock

Surveyors Seal

**REGISTERED
 PROFESSIONAL
 LAND SURVEYOR**

Stephen K. Haddock

**OREGON
 JULY 9, 2001
 STEPHEN K. HADDOCK
 56295LS**

RENEWAL DATE 6-30-11

RECEIVED BY:
 Umatilla County Surveyor
 Date: 6-10
 Rec'd By: KK
 No. 10-98-C