

D-11


OREGON CORNER RESTORATION FORM

Section 3 Township 1N Range 34E

County Umatilla Date 9/17/87

D-14

Corner Designation

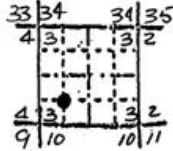

S.W. 1/16

- Condition Report Only
- Not Found
- Renewed
- Unrecorded
- Surveyed In
- Referenced Out

Previous Renewals/Surveys, etc.

Gov't. Indian Allotment survey, 1919.


Monument(s) & Accessories Found: (Condition and Source)

Found brass cap on 2" iron pipe.
No. BT's found.

Monument Detail



Sketch

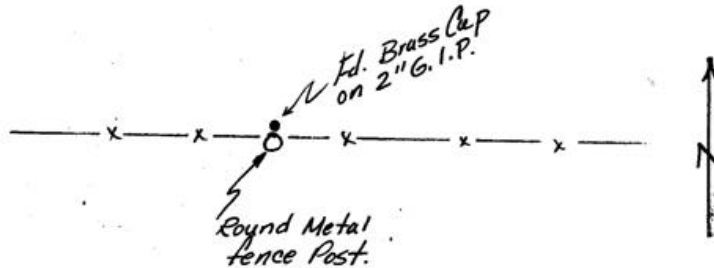

Monument Set (Procedures and Description)

New Accessories

Location & Comments

No. BT's found.
Blue Mountain Forest
Wayside boundary
survey SE 1/4 Sec. 4 and
SW 1/4 Sec. 3.

RECEIVED BY

Umatilla County Surveyor

Date 2-88

Rec'd By HT

No. 88-10-B

Compass Declination 20°

Firm/Agency Oregon State
Parks & Recreation Div.

Address 525 Trade Street SE
Salem OR 97310

Party Chief R. Hemmer

Notes R. Hemmer

Witness L. Boge, H. Hanson

Seal

REGISTERED
PROFESSIONAL
LAND SURVEYOR

John E. Hollingsworth

OREGON
JULY 9, 1908
JOHN E. HOLLINGSWORTH
691