

OREGON CORNER RESTORATION FORM


Section 3 Township 1N Range 34E

County Umatilla Date 9/17/87

D-15

Corner Designation

C.S. 1/16

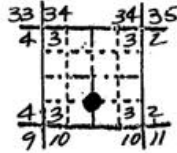

- Condition Report Only
- Not Found
- Renewed
- Unrecorded
- Surveyed In
- Referenced Out

**Previous Renewals/Surveys, etc.**

Gov't Indian Allotment survey 1919.


**Monument(s) & Accessories Found: (Condition and Source)**

Found brass cap on 2" iron pipe in a small mound of stone.  
No BT's found.

**Monument Detail**



**Sketch**

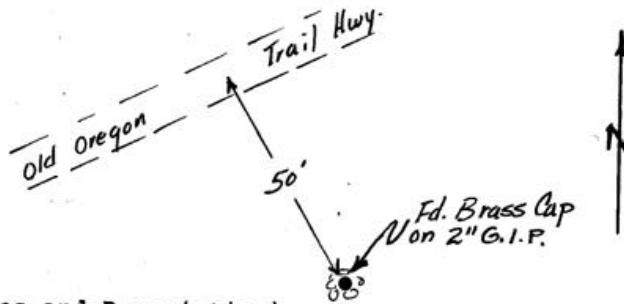

**Monument Set (Procedures and Description)**

**New Accessories**

**Location & Comments**

Blue Mountain Forest  
Wayside boundary  
survey SE 1/4 Sec. 4 and  
S 1/2 Sec. 3.

Compass Declination 20°  
Firm/Agency Oregon State  
Parks & Recreation Div.  
Address 525 Trade Street SE  
Salem OR 97310

**Seal**



**RECEIVED BY**

Umatilla County Surveyor  
Date 2-88  
Rec'd By KA  
No. 88-10-B

Party Chief R. Hemmer  
Notes R. Hemmer  
Witness L. Boge, H. Hanson