

E-13

OREGON CORNER RESTORATION FORM


Section 4 Township 1N Range 34E

E-13

County Umatilla Date 9/16/87

Corner Designation

Section Corner
3, 4, 9, and 10

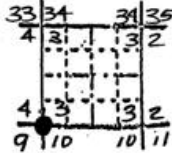

- Condition Report Only
- Not Found
- Renewed
- Unrecorded
- Surveyed In
- Referenced Out

Previous Renewals/Surveys, etc.

Gov't. Indian Allotment Survey, 1919.


Monument(s) & Accessories Found: (Condition and Source)

Found brass cap on 2" iron pipe in mound of stone at old fence corner.
No BI's in evidence.

Monument Detail



Sketch

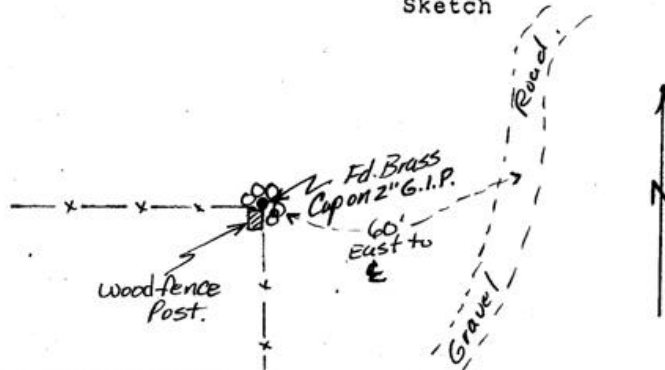

Monument Set (Procedures and Description)

New Accessories

Location & Comments

Blue Mountain Forest
Wayside boundary
survey SE Sec. 4 & S½
Sec. 3.

Compass Declination 20°
Firm/Agency Oregon State
Parks & Recreation Div.
Address 525 Trade Street SE
Salem OR 97310

Seal

REGISTERED
PROFESSIONAL
LAND SURVEYOR

RECEIVED BY
Umatilla County Surveyor
Date 2-88
Rec'd By [Signature]

Party Chief R. Hemmer
Notes R. Hemmer
Witness L. Boge, H. Hanson

John E. Hollingsworth
OREGON
JULY 9, 1968
JOHN E. HOLLINGSWORTH
691