

CERTIFIED RECORD OF LAND CORNER MONUMENTATION

HISTORY OF ORIGINAL CORNER ESTABLISHED:

The corner was originally established by B.I.A. surveyor C.E. Redfield.

T 1 N R 34 E J-20

Corner monumented by BLM Surveyor Bryan S. Seibold in 2002 under special instructions dated May 19, 1999 and included group number 1913. Field notes state:

There is no remaining evidence of the cor. established by C.E. Redfield. Set a stainless steel post, 28 ins. long, 2 1/4 ins. diam., 26 ins. in the ground, in a collar of stone, with brass cap marked as shown

	S	14

S 11
E 1/16 -----
S 14
2002

From which:

A fir, 15 ins. diam., bears N. 6 1/4 E., 91.2 ft. dist., mkd. E1/16 S11 BT.
A fir, 19 ins. diam., bears S. 50 3/4 E., 18.6 ft. dist., mkd. E1/16 S14 BT.

DESCRIPTION OF CORNER EVIDENCE FOUND:

Found a 3" brass cap marked as shown sitting flush with the ground, in a 2. ft diam collar of stone, from which:

A 19" Douglas fir bears North 6° East 91.20 ft., alive and vigorous with a healed blaze.
A second bearing tree completely uprooted and fallen over the edge of a small cliff so that the original position could not have been accurately ascertained. Tree had been partially buried by a landslide so the diameter could not be accurately ascertained.

DESCRIPTION OF MONUMENT AND ACCESSORIES I ESTABLISHED TO PERPETUATE THE ORIGINAL LOCATION OF THIS CORNER:



From the brass cap monument,

NEW BEARING TREE:

A 13 inch Douglas fir bears South 36° West 20.10 ft., marked E 1/16 S14 BT.

I hereby certify that the corner was perpetuated on September 13, 2018.

Witness: Ryan Skeen

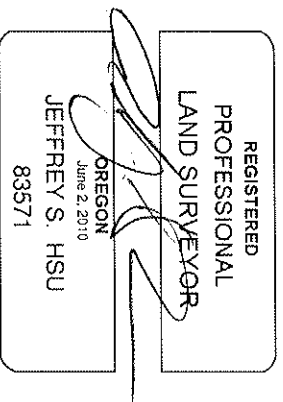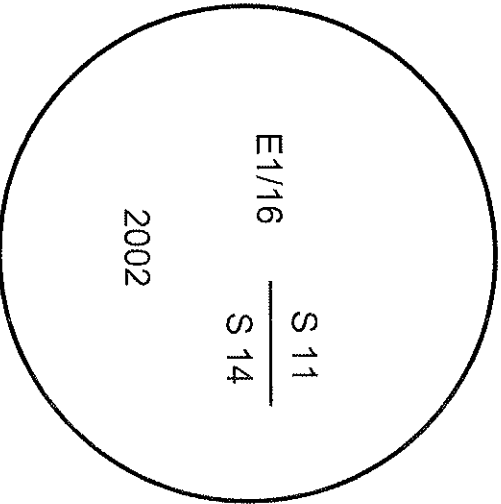

Renewal Date: June 30, 2019

RECEIVED BY

Umatilla County Surveyor
Date: 10/23/2018
Record By: TMH
No.: 18-094-R

I used a steel tape and magnetic compass in the establishment of the new accessories. I used 13° East declination, the distances are to a 60d spike driven into the side of the root crown of the bearing trees. A brass washer marked OPLS 83571 is attached to the BT blaze of the new bearing trees.