

**CERTIFIED RECORD OF LAND CORNER MONUMENTATION**


**HISTORY OF ORIGINAL CORNER ESTABLISHED:**

Corner originally established under GLO Special Instructions dated May 4, 1887 executed by N. Currin and E. Noland. Surveyor General record states:

Set post 36x3x3 ins. 2 ft. in the ground for 1/4 Sec. Cor, mkd 1/4 S on W. face, from which:  
A pine 28 ins. in diam. bs. N.10°E., dist 62 lks. mkd. 1/4 S BT.  
A pine 12 ins. in diam. bs. S30°W., dist. 30 lks. mkd 1/4 S BT.

Corner was recovered by L. E. Wilkes in Dependent Resurvey completed under GLO Contract No. 29, dated May 3, 1917. No mention of monument.

T 1 N R 35 E L-01

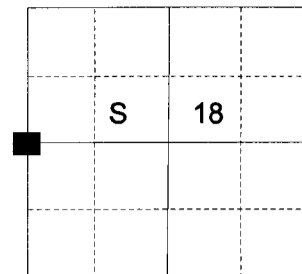

**DESCRIPTION OF CORNER EVIDENCE FOUND:**

Found an 18"x11"x8" basalt stone, firmly set in the ground 12 inches deep, with '1/4' chiseled on West face, from which:  
A pine, dead and downed, the stump hole which bears North 10° East, a distance of 41 feet. Tree is in a state of decay and the original size cannot be accurately ascertained.

A pine stump bears South 30° West, a distance of 20 feet, with a healed blaze evident. No scribe marks found. Stump is in a state of decay and the original size cannot be accurately ascertained.

**DESCRIPTION OF MONUMENT AND ACCESSORIES I ESTABLISHED**


**TO PERPETUATE THE ORIGINAL LOCATION OF THIS CORNER:**

At the stone position, I set a 2 1/2" x 30" aluminum pipe with 2 1/2" aluminum cap, marked as shown below, 27 inches in the ground, in a collar of stone 1 1/2 ft. diam., from which:

A 16 inch Douglas Fir bears North 39° East, a distance of 101.00 feet, marked 1/4 S18 BT.  
A 9 inch White Fir bears South 30° East, a distance of 93.90 feet, marked 1/4 S18 BT.  
A 5/8" x 15" iron rebar bears South 45°57' West, a distance of 22.45 feet, with 1 1/2" aluminum cap marked BGB SURVEY MARKER SW RP.  
A 5/8" x 15" iron rebar bears North 36°33' West, a distance of 20.89 feet, with 1 1/2" aluminum cap marked BGB SURVEY MARKER NW RP.

Set a steel fencepost approximately 1 foot South of corner monument.

I hereby certify that the corner was perpetuated on October 8, 2014.

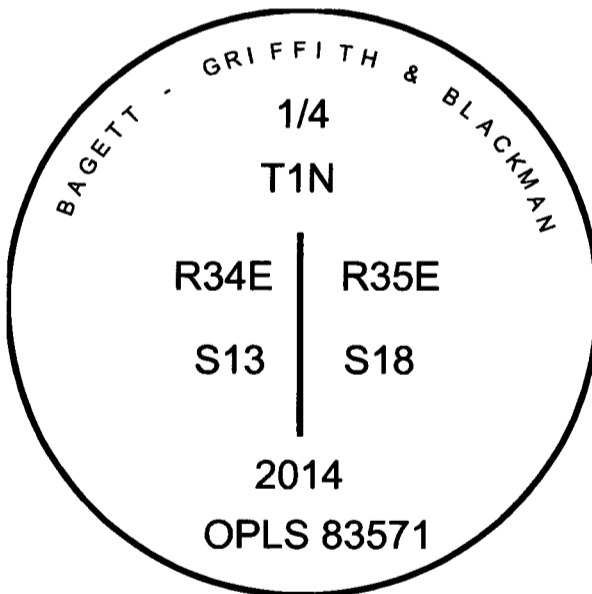

I used a steel tape and magnetic compass in the establishment of the new bearing trees. I used 16° East declination, the distances are to a 60d spike in the right hand side of the root crown. I use a Leica GS15 RTK GPS in the establishment of the new rebar accessories. Basis of bearing is a per survey for Hancock Forest Management, dated October 2014.

14-137-B