

CERTIFIED RECORD OF LAND CORNER MONUMENTATION

HISTORY OF ORIGINAL CORNER ESTABLISHED:

Corner originally established under GIO Special Contract dated May 4, 1887, executed by James P. Currin and James E. Noland. Surveyor General field notes state:

T 1 N R 34 E P-21

Set stone 12x12x6 in., 8 ins. in the ground, for 1/4 Sec. cor. marked 1/4 on W. face and raised a mound of stone over it. pits impracticable.

	S	23	

DESCRIPTION OF CORNER EVIDENCE FOUND:

None.

DESCRIPTION OF MONUMENT AND ACCESSORIES I ESTABLISHED TO PERPETUATE THE ORIGINAL LOCATION OF THIS CORNER:



At proportionate position, I set a 2 1/4" x 30" aluminum pipe, 12 in. in the ground, with a 2 1/4" aluminum cap, marked as shown below, in a mound of stone 2 ft. diam., from which:

NEW BEARING OBJECTS:

A 5/8" x 15" iron pin bears North 68°16' East, a distance of 20.30 feet, with 1 1/4" aluminum cap marked BGB SURVEY MARKER.
 A 5/8" x 15" iron pin bears South 68°43' East, a distance of 35.25 feet, with 1 1/4" aluminum cap marked BGB SURVEY MARKER.
 A 17" Ponderosa Pine bears South 63° West, a distance of 197.60 feet, marked 1/4 S23 BT.
 A 5/8" x 15" iron pin bears North 31°15' West, a distance of 24.93 feet, with 1 1/4" aluminum cap marked BGB SURVEY MARKER.

I certify this corner was monumented October 10, 2018.

Witness: Kyle Tucker, Renee Naumann

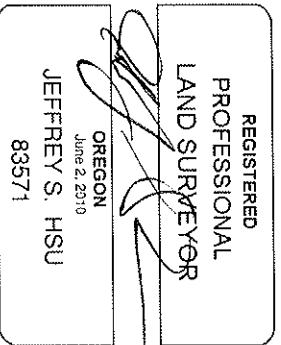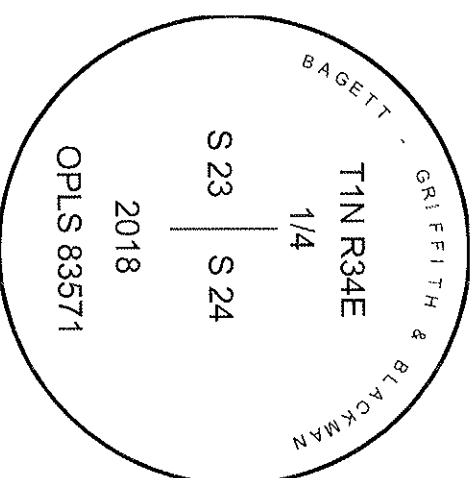

Renewal Date: June 30, 2019

I used a RTK GPS in the establishment of the new accessories. Basis of bearing is as per survey for Hancock Forest Management dated Oct. 2018. Bearing to the bearing tree is to a brass washer marked OPLS 83571 in the lower blaze. Distance is to a 60d spike in the side of the root crown. Bearings and distances to the aluminum caps are to the center.

RECEIVED BY

Umatilla County Surveyor

Date: 10/23/2018

Added By: JMA

No.: 18-094-R