

CERTIFIED RECORD OF LAND CORNER MONUMENTATION


HISTORY OF ORIGINAL CORNER ESTABLISHED:

Corner was originally established under GLO Special Joint Contract, dated May 4th, 1887, executed by Currin and Noland. Surveyor General field notes state:

Set stone 9x8x7 ins., 6 ins. in the ground for 1/4 sec. cor. marked 1/4 on W face, raised mound of stone over it. Pits impracticable.

The Original Redfield Field Notes of the Umatilla Indian Reservation dated 1917-1919, Book #1, Umatilla County Surveyor Records shows that in 1919, Redfield, as part of the allotments and patents of the Umatilla Indian Reservation, set a monument.

T 1 N R 35 E C-21

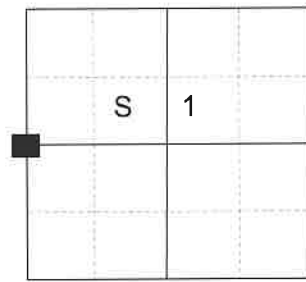

DESCRIPTION OF CORNER EVIDENCE FOUND:

Found a 2 1/2" galvanized pipe with 2 1/2" brass cap marked as shown below, 26" above ground and heavily leaning downhill.

DESCRIPTION OF MONUMENT AND ACCESSORIES I ESTABLISHED TO PERPETUATE THE ORIGINAL LOCATION OF THIS CORNER:


I further excavate the base of the pipe to determine the exact point and reset it upright and 10" in the ground, in a 3 ft. mound of stone at base to within 10" of cap, and on a steep South facing slope, from which:

NEW BEARING OBJECTS:

- A 3/4" x 2" magnet encased in silver and black plastic bears North 82°44' East, a dist. of 11.85 feet.
- A 3/4" x 2" magnet encased in pink and black plastic bears South 42°31' East, a dist. of 13.71 feet.
- A 2' x 3' x 4' rock outcrop bears South 69°29' West, a dist. of 8.38 feet, marked X BO.
- A 12' x 14' x 10' rock outcrop bears North 14°43' West, a dist. of 14.55 feet, marked X BO.

I hereby certify that the corner was perpetuated September 9, 2025

Witness: Kyle Tucker

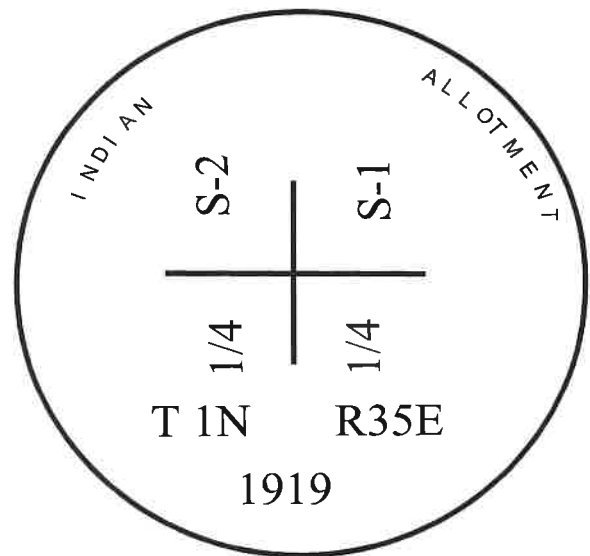

REGISTERED
PROFESSIONAL
LAND SURVEYOR

OREGON
June 2, 2010
JEFFREY S. HSU
83571

Renewal Date: June 30, 2027

I use a Leica GS18 with RTK in the establishment of the new bearing objects. Basis of Bearing is as per map of survey filed concurrently. Bearings and distances are measured from the center of the brass cap to the center of the X's or the center of the magnets. Magnets are buried 6" deep with colored side facing upwards.

C-21

25-087-B