


**CERTIFIED RECORD OF LAND CORNER MONUMENTATION**

**HISTORY OF ORIGINAL CORNER ESTABLISHED:**

Corner not previously established

T 1 N R 35 E K-11

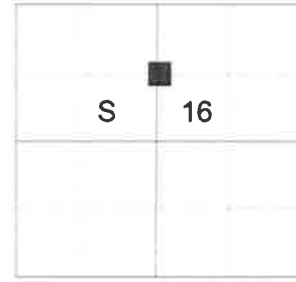

**DESCRIPTION OF CORNER EVIDENCE FOUND:**

None

**DESCRIPTION OF MONUMENT AND ACCESSORIES I ESTABLISHED**

**TO PERPETUATE THE ORIGINAL LOCATION OF THIS CORNER:**

At position determined by survey, I set a 5/8" x 30" iron pin, 26" in the ground with a 2 1/2" Aluminum cap marked as shown below, from which:

**NEW BEARING TREES:**


A 5/8" x 15" Iron Pin bears North, a distance of 20.00 feet, with 1 1/2" aluminum cap marked BGB SURVEY MARKER N RP.

A 5/8" x 15" Iron Pin bears West, a distance of 20.00 feet, with 1 1/2" aluminum cap marked BGB SURVEY MARKER W RP.

Set a steel fencepost North approx. 1.0 ft.

I hereby certify that the corner was monumented June 23, 2017.

Witness: Kyle Tucker

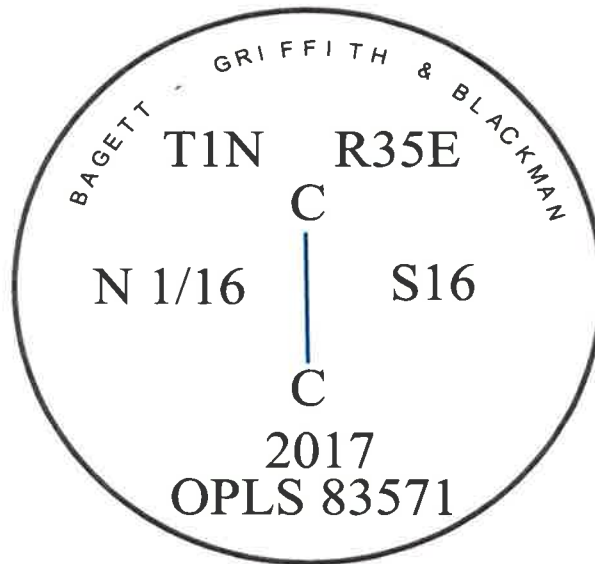

I used a steel tape and magnetic compass in the establishment of the bearing objects. Magnetic declination used was 13° East. Bearings and distances are to the center of the aluminum caps.