


**CERTIFIED RECORD OF LAND CORNER MONUMENTATION**

**HISTORY OF ORIGINAL CORNER ESTABLISHED:**

Corner not previously established.

T 1 N R 35 E N-02

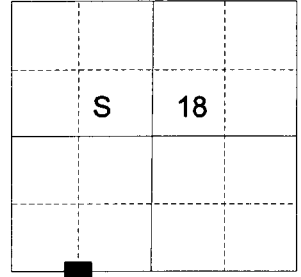

**DESCRIPTION OF CORNER EVIDENCE FOUND:**

None.

**DESCRIPTION OF MONUMENT AND ACCESSORIES I ESTABLISHED**

**TO PERPETUATE THE ORIGINAL LOCATION OF THIS CORNER:**

At position determined by survey, I set a 5/8" x 24" iron rebar, 22 inches in the ground, with a 2 1/2" aluminum cap, marked as shown below, from which:

A 16 inch Western larch bears North 6° East, a distance of 60.45 feet, marked W 1/16 S18 BT.


A 16 inch Ponderosa Pine bears South 51° East, a distance of 19.90 feet, marked W 1/16 S19 BT.

Set a steel fencepost approximately 1 foot North of corner monument.

I hereby certify that the corner was monumented on October 9, 2014.



Renewal Date: June 30, 2015

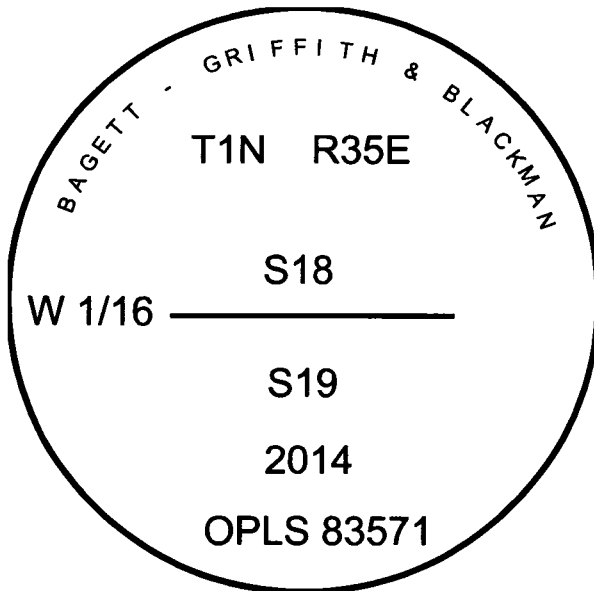

I used a steel tape and magnetic compass in the establishment of the new bearing trees. I used 16° East declination, the distances are to a 60d spike in the right hand side of the root crown.