

U. S. Department of Agriculture
FOREST SERVICE

Umatilla NATIONAL FOREST

CORNERS OF THE PUBLIC SURVEY

T. 1 N. R. 35 E Will. Mer.

Section Corner common to Sections

13, and 24

Corner consists of a Mundy Rock in place

State condition good

Dimensions above ground 18" inches.


Sketch grooves, letters, figures, or notches, on proper face or edge.

CARDINAL POSITION

DIAGONAL POSITION



N W S E

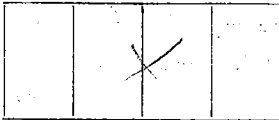


NW SW SE NE

Mound of _____ is located _____

Pits are located _____

Sketch markings of Bearing Trees (or Rocks) in proper box and fill blanks below, giving bearings from Corner to Trees and Distances in Links.

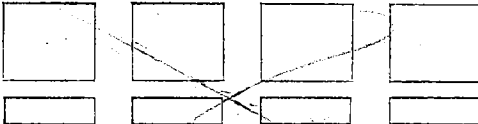

Species _____

Diameter _____

Bearing _____

Distance _____

Do you believe this to be a genuine Land Office Corner? Yes

If not, why? Some have found

N. E. & W. of corner, all

sketches on mound, noted away.

Arthur J. Jones

(Signature)

6/1/48


(Date)

Eng. Aide

(Title)

T. 1 N R. 35 E Will. Mer.

(Make sketch of topography near Corner and show section line markers thus "X")

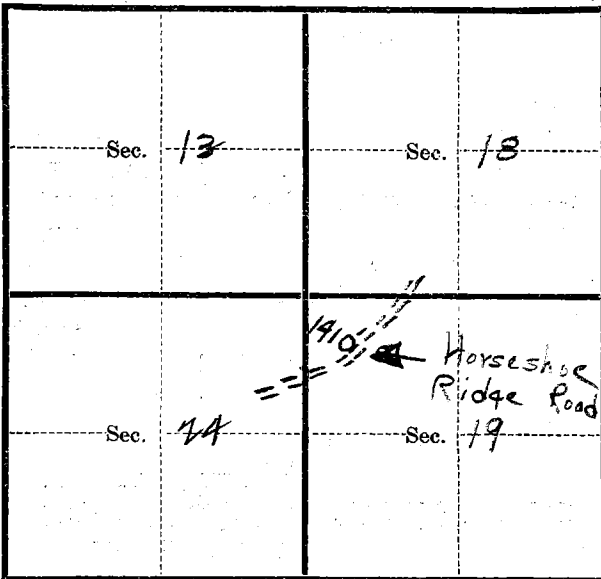

Metal Location Poster is on a _____
tree _____ inches diameter, on the _____
side of _____ from which
this Corner bears _____', _____ Chains.
(Bearing) (Distance)
Section line marker between Secs. _____ and _____ is on
a _____ on the _____
(Tree, post, etc.) (Name of road, trail, etc.)
located _____ chains E, W, N, S., from Sec. Cor.; 1/4 Cor.; Witness Cor.
(Cross out nonapplicable)
Give any further facts needed to find Corner again:

Census tag placed
on 27" y.p. at
Horseshoe Ridge Road
1410' South of Corner.