

**OREGON CORNER RESTORATION FORM**

Section 19 Township 1N Range 35E  
 County Umatilla Date: September 29, 2008

Corner Designation: 1N35N3

Quarter corner to sections 18 and 19, T1N, R35E,  
 W.M., Umatilla County, Oregon.

Condition Report Only  
 Not found  
 Remonumented  
 Unrecorded  
 Surveyed in  
 Referenced out


Previous Renewals / Surveys, etc.

Corner originally set by James Currin and James Noland under special instructions dated May 4th 1889. Their record reads: A pine, 16 ins. in diam. marked 1/4 S. on N. face for 1/4 sec. cor; from which a pine 12 ins. in diam. bears N20° W 60 lks. dist. marked 1/4S.B.T.; a pine 10 ins. in diam. bears S55°W 25 lks. dist. marked 1/4 S.B.T.

Monument and Accessories found: ( condition and source )

The decayed "solid pitch" pine core of the S.W. BT stump with the bottom of the blazed face and a partial scribe. Also, the remains of the "solid pitch" core of the 1/4 corner tree about 8 feet long lying on its side with no visible remains of the corner markings.

**DIAGRAM**

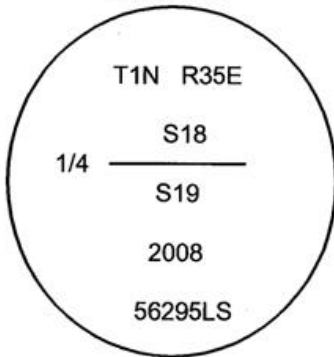

**SKETCH**

**MONUMENT (S) AND ACCESSORIES SET (Procedures and Description)**

In the stump hole of the 1/4 corner pine snag I set a 1"x24" iron rebar with a 2" aluminum cap stamped as shown in the diagram above.

For references, I set four 5/8" by 24" rebars with 1 1/8" orange plastic caps stamped WTS and 56295LS as described below:

- an iron rebar bears S04°49'54"E, 72.41 feet;
- an iron rebar bears N22°25'47"E, 122.85 feet;
- an iron rebar bears N50°15'28"W, 77.30 feet;
- an iron rebar bears S34°26'24"W, 108.12 feet;

The monument and references were tied using a Trimble R7/R8 RTK GPS system.

Location and comments

Compass Declination

Surveyors Seal

RECEIVED BY:  
Umatilla County Surveyor  
 Date: 10/27/08  
 Rec'd By: [Signature]  
 No. 08-145-B

Firm / Agency  
 Witness Tree Surveying  
 Address  
 P.O. Box G  
 Pilot Rock, Or. 97868  
 Party Chief  
 Stephen K, Haddock

REGISTERED  
 PROFESSIONAL  
 LAND SURVEYOR

*Stephen K. Haddock*

OREGON  
 JULY 9, 2001  
 STEPHEN K. HADDOCK  
 56295LS

RENEWAL DATE 6-30-09