


CERTIFIED RECORD OF LAND CORNER MONUMENTATION

HISTORY OF ORIGINAL CORNER ESTABLISHED:

Corner not previously established.

T 1 N R 35 E O-05

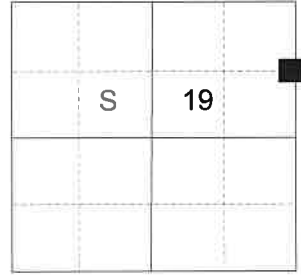

DESCRIPTION OF CORNER EVIDENCE FOUND:

None.

DESCRIPTION OF MONUMENT AND ACCESSORIES I ESTABLISHED TO MONUMENT THE ORIGINAL LOCATION OF THIS CORNER:


At position by Survey I set a 5/8" x 30" iron pin, 27" in the ground, with 2 1/2" aluminum cap marked as shown below, from which:

NEW BEARING OBJECTS:

- A 4" Douglas Fir bears North 79° East a dist. of 26.05 ft., marked X BT.
- A 6" Douglas Fir bears North 22° West a dist. of 19.30 ft., marked N 1/16 S19 BT.

Set steel fence post approx. 0.5 ft. West

I hereby certify that the corner was monumented on October 10, 2019.
Witness: Kyle A. Tucker

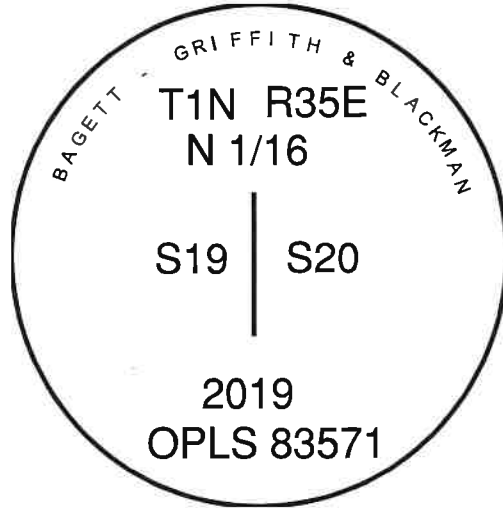

I used a steel tape and magnetic compass in the establishment of the new accessories. I used 13° East declination, the distances are to a 60d spike driven into the right side of the root crown of the bearing trees. A brass washer marked OPLS 83571 is attached to the BT blaze of the new bearing trees.